

DX 78-1

14


22

14<sup>W</sup>

Section \_\_\_\_\_ Township \_\_\_\_\_ Range \_\_\_\_\_

Well No. 1 Smith

Company Harms-Burt et al

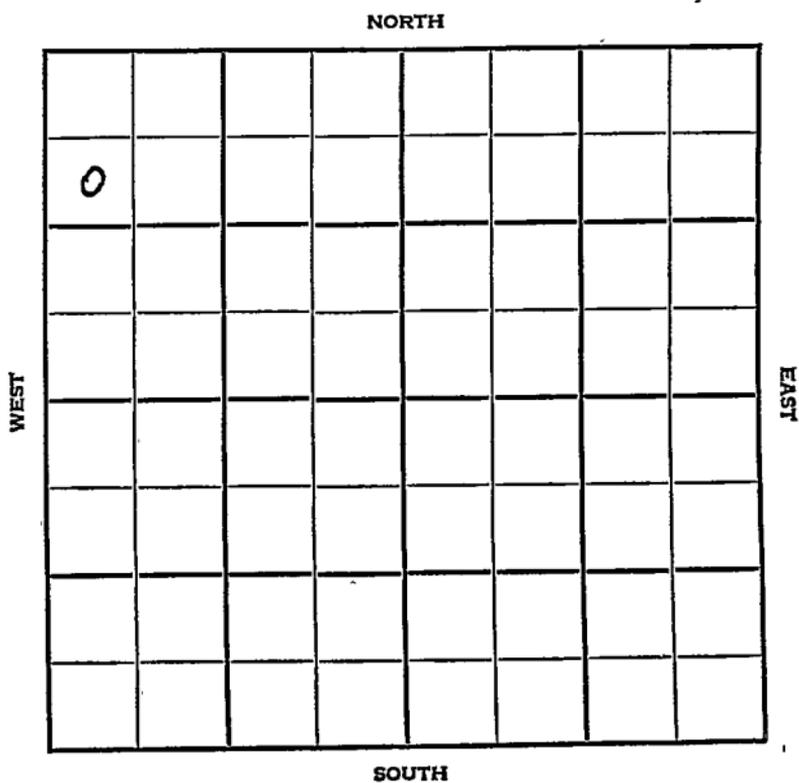

Stafford KANSAS

SEC.	TWP.	R.
14	22-	14W

WELL NO. \_\_\_\_\_

1 Smith FARM

COMPANY

Harms-Burt et al

CONTRACTOR


Wildcat

990 \_\_\_\_\_ Ft. from N. Line

\_\_\_\_\_ Ft. from S. Line

\_\_\_\_\_ Ft. from E. Line

330 \_\_\_\_\_ Ft. from W. Line

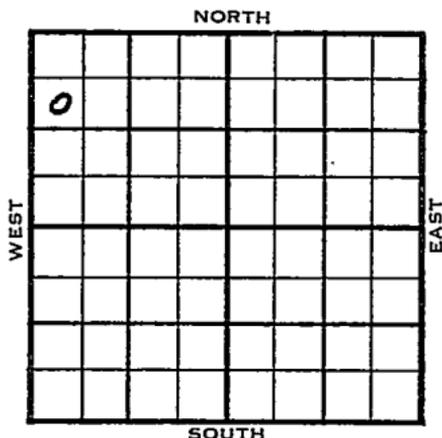

SW NW NW  
CSO 1/2 int.

1954	ELEVATION	REPORT
7/7 7/21	1937'	<p>Drlg. 1770</p> <p>D &amp; A TD 3810 8" @ 230</p> <p>Heeb 3300 Br. lime 3424 Lans 3434</p> <p>DST 3550-65 open 55 min, rec 20' mud 1040#</p> <p>DST 3590-3605 open 1 hr rec 600' gas, 90' HOCM 305#</p> <p>DST 3614-38 open 1 hr rec 10' mud 30#</p> <p>B KC 3657 Cong 3698 Viola 3711</p> <p>Simp. 3746 Arb. 3798</p> <p>DST 3799-3810 open 1 hr rec 600' sul. wtr. TD 3810 D &amp; A</p> <p><b>ABANDONED</b></p>



County Stafford State Kansas

Sec. 14 (Blk. Twp.) 22 (Sur. Rge.) 14W Map No.

Operator Harms-Burt etal.

Well No. 1 Farm Smith

Elev. 1937 Location SW NW NW


990 Ft. From N Line NW

330 Ft. From W Line Quarter

Ist. Report

JUL 21 1954

Completion

Remarks Wildcat

Spudding Date

Drlg. Data D & A TD 3810

8" @ 230 Heeb. 3300 Br. lime 3424

Lans. 3434 DST 3550-65 open 55 min.

Rec. 20' mud 1040# DST 3590-3605

open 1 hr. Rec. 600' gas 90' hocr

305# DST 3614-38 open 1 hr. Rec.

10' mud 30# B KC 3657 Cong. 3698

Viola 3711 Simp. 3746 Arb. 3798

DST 3799-3810 open 1 hr. Rec. 600' sul.

wtr. TD 3810

D & A