

DX 78-1

NORTH

WEST

EAST

0

SOUTH:

Stafford KANSAS

SEC.	TWP.	R.
14	22	14W

WELL NO.

3 McBride FARM

COMPANY

M. B. Armer

CONTRACTOR

Armer


N. Oscar Pool

Ft. from N. Line

990 Ft. from S. Line

Ft. from E. Line

330 Ft. from W. Line

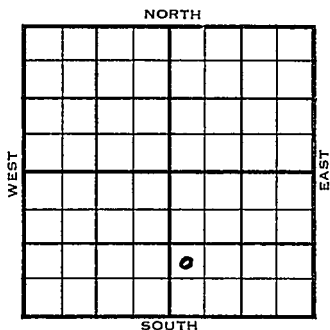

NW SW SE

	ELEVATION	REPORT
1954	1930'	

8/4 Spud 8-2-54
8" @ 350', WOC
8/18 Spud 8-2-54 D & A TD 3824
8" @ 350' Heeb 3300 Br lime 3430
Lans 3442 Viola 3711 Simp. 3738
Arb. 3789
DST 3790-95 open 1 hr rec 25' SOCM
10' wtr. 660# TD 3824
D & A

ABANDONED

County Stafford State KansasSec. 14 (Blk. Twp.) 22 (Sur. Rge.) 14W Map No.Operator M. B. ArmerWell No. 3 Farm McBrideElev. Location NW SW SE


FIRST REPORT

990 Ft. From S Line SE330 Ft. From W Line Quarter1st. Report AUG 4 1954

Completion

Remarks Phillips farmoutArmer - Contr.Spudding Date 8-2-54Drlg. Data N. Oscar Pool8" @ 350 WOC

J. G. McGEHEE

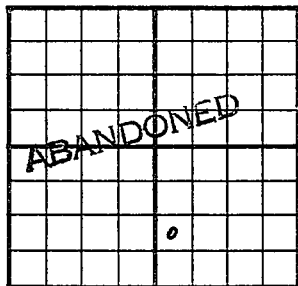County Stafford State KansasSec. 14 (Blk.) 22 (Sur.) 14W Map No.Operator M. B. ArmerWell No. 3 Farm McBrideElev. 1930 Location NW SW SE990 Ft. From S Line SE330 Ft. From W Line Quarter1st. ReportCompletion AUG 18 1954Remarks N. Oscar PoolArmer - Contr.Spudding Date 8-2-54Drig. Data D & A TD 38248" @ 350 Heeb. 3300 Br. lime 3430Lans. 3442 Viola 3711 Simp. 3738Arb. 3789 DST 3790-95 open 1 hr.Rec. 25' socm 10' wtr. 660#TD 3824D & A

FABEN GILSTRAP