


Section 14 Township 22 Range 12-WWell No: #1 KrankenbergCompany North American Prod.

NORTH

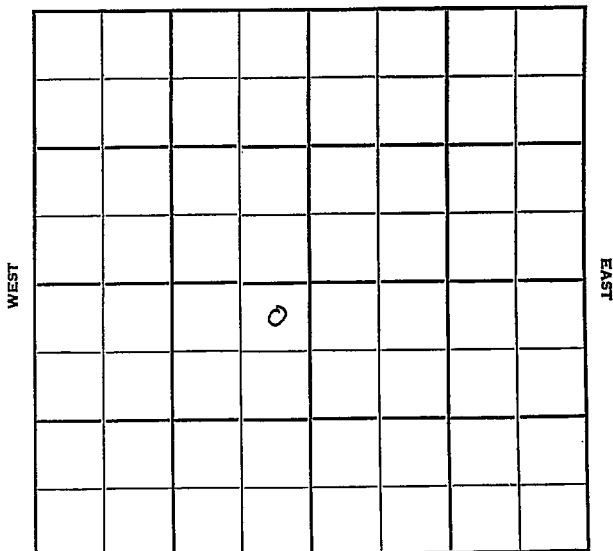

SOUTH

KANSAS

Stafford

Sec. 14 Twp. 22 R. 12-W

Well No. #1 Krakenberg Farm

North American Prod. Company

Harbar Drlg. Contractor

Hayden

330

Ft. from N. Line


Ft. from S. Line

330

Ft. from E. Line

Ft. from W. Line

NE NE SW

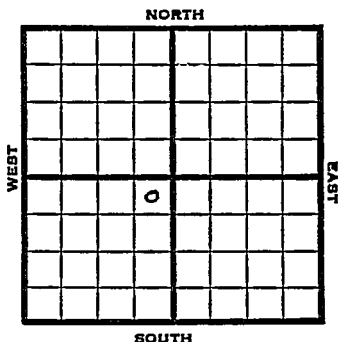

1951

Elev. 1862

REPORT

'1/10

Spud 12-31-50

8" @ 201

Anhy 650

Drlg 2800'

1/31

Spud 12/31/50

Oil well TD 3663

8" @201

Anhy 650 Lans. 3311 Cong 3569

Viola 3580 Simp. 3620 Arb. 3657-62


5" @ 3658 TD 3663

s/ 55 bo 10 hr.

Comp. 150 bopd

COMPLETED

County Stafford State Kansas
 Sec. 14 (Blk.) 22 (Sur.) 12W Map No.
 (Twp.) (Rge.)
 Operator North American Prod.
 Well No. 1 Farm Krankenber
 Elev. Location NE NE SW

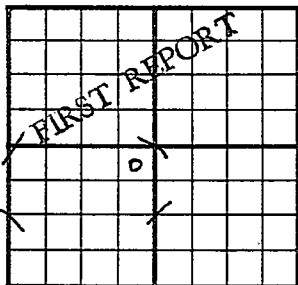

330 Ft. From N Line SW
330 Ft. From E Line Quarter

1st. Report JAN 1 0 1951

Completion

Remarks

Harber Drlg. - Contr.


Spudding Date 12-31-50

Drlg. Data Heyden Pool

8" @ 201 Anhy 650 drlg. 2800

J. E. TYRA

County Stafford State Kansas
 Sec. 14 (Blk.) 22 (Sur.) 12W Map No.
 (Twp.) (Rge.)
 Operator North American Prod.,
 Well No. 1 Farm Krankenbergl
 Elev. 1862 Location NE NE SW

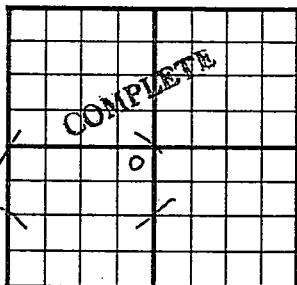

330 Ft. From N Line SW
330 Ft. From E Line Quarter
 1st. Report
 Completion JAN 31 1951
 Remarks Heyden Pool
Harbar Drlg. - Contr.
 Spudding Date 12-31-50

Drlg. Data Oil well TD 3663
8" @ 201 Anhy 650 Lans. 3311
Cong. 3569 Viola 3580 Simp. 3620
Arb. 3657-62 5" @ 3658 TD 3663
S/ 55 bo 10 hr. Comp. 150 bopd

J. E. TYRA