


Section 14 Township 22 Range 12W

Well No. #3 Krankenberg

Company Bay Petr.

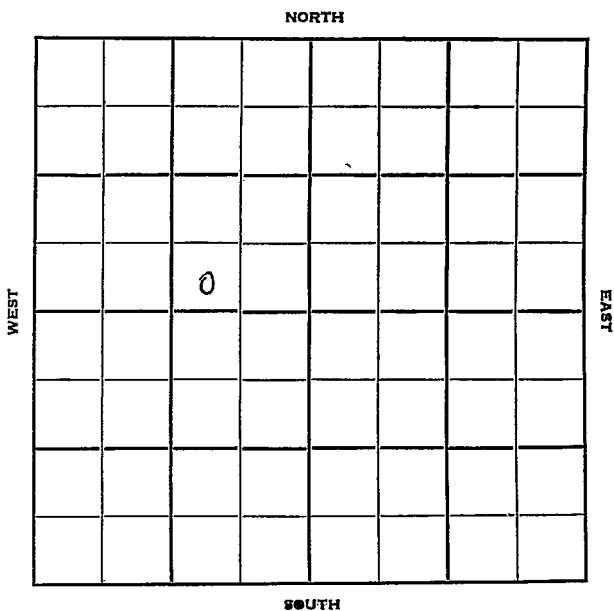

Sec. 14 Twp. 22 R. 12W

Well No. #3 Krankenberg Farm

Bay Pet. Company

Pickrell Drlg. - Contr. Contractor

Heyen Pool


_____ Ft. from N. Line

330' Ft. from S. Line

990' Ft. from E. Line

_____ Ft. from W. Line

SW SE NW

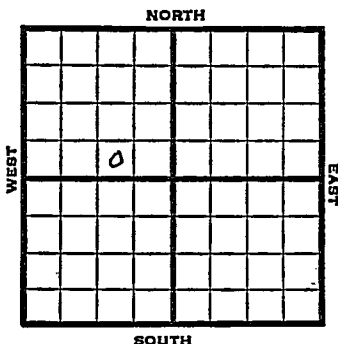

1951

Elev. 1858' REPORT

6/6 Spud 6-3-51
8" @ 267
Drlg. 1350'

8/15 Spud date 6-3-51
Oil Well TD 3667
8" @ 267
Heeb. 3150 Br Lime 3283
Lans. 3299
DS 3436-46 opn 45 min.
Rec. 30' o & gcm 50' mud & sw
DST 3479-3503 opn 1 hr Rec. 10'
o & gcm
Cong. 3576 Viola 3581
DST 3582-3611 opn 75 min.
Rec. 65' wcm Arb. 3681
DST 3661-66 opn 1 hr Rec. 30' o & gcm
5" @ 3662 TD 3666 500 A
Test 1/2 boph DD 3667 30 goph
1000 A 1 bo 3/4 bwph inc. to 2 boph
Comp. 50 bopd 50 bw

COMPLETED

