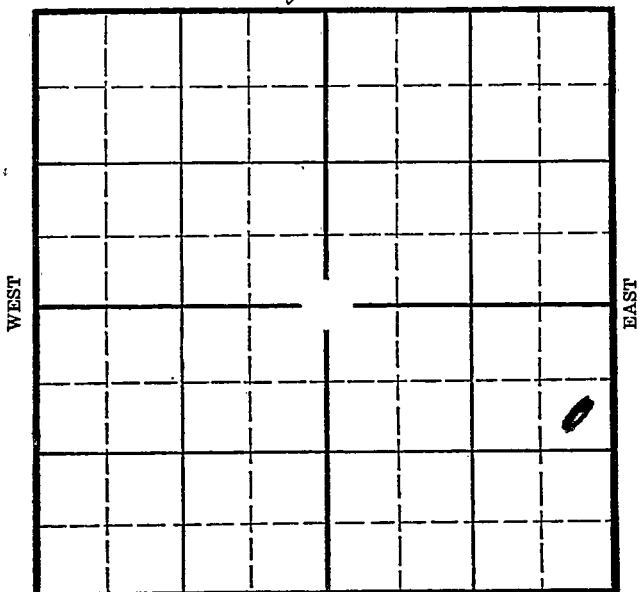

Company

NORTH



SOUTH

Location_____

Drilling Remarks

Rig Up

Drilling Remarks

RECORD

Cased _____ in. _____ ft.

Sand_____

Gas_____

Oil

Total Depth_____

PRODUCTION

1st 24 hrs. Nat. _____

1st 24 hrs. after shot_____

Gas_____cu. ft._____

Dry Hole

Abandoned

Map No. KANSAS Sec. 14 Twp. 22 R. 2
Well No. 1- Ervey Farm
Sunray Oil Company


990 Ft. from N. Line

 Ft. from S. Line

330 Ft. from E. Line

 Ft. from W. Line

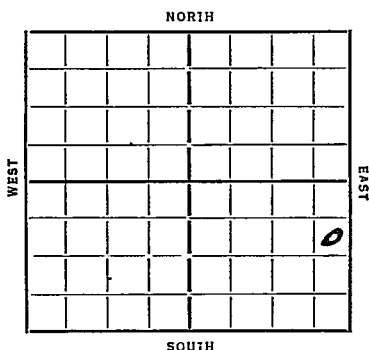Elev. 1470



Date 7/3/5 REPORT
7/10 Powder
7/18 -
8/8 T @ 2935 2944 sh.
8/15 8" 3275
8/22 BML 3262 Hurton 3272
8/29 so 3297 3310 TD 90' Oil
9/6 25 Pbls
9/14 an potential
10/3 Oil 3502-15 P/B to Chert
10/10 -
10/17 Oil 3502
TD 3515
Perforated pipe 2555-58 1/2
12,700,000 lbs.

COMPLETED

Map No. 43 Sec. 14 Twp. 22 R. 24Well No. 1 - EmvSunray oil CompanyTHS REPORTS Contractor

SECTION PLAT

990 Ft. from N. Line

Ft. from S. Line

330 Ft. from E. Line

Ft. from W. Line

			0

Location.....

Rig up.....

Drilling and Remarks:

RECORD

Cased.....in.,ft.

Sand.....

Gas.....

Oil.....

Total Depth.....

PRODUCTION

1st 24 hrs. Nat.....

1st 24 hrs. after shot.....

Gas.....Cu. Ft.

Dry Hole.....

Abandoned.....

Date

ORVAL MANNSCHRECK

7-10-35 192 Scout

KANSAS

Map No. 43 Sec. 14 Twp. 22 R. 2WWell No. 1-EwySunray Oil Company

Contractor

COMPLETED

SECTION PLAT

990 Ft. from N. Line

Ft. from S. Line

330 Ft. from E. Line

Ft. from W. Line

			0

Location

Rig up

Drilling and Remarks:

Perforated
Pipe 2555-58½12,709,000
910

RECORD

Cased _____ in., _____ ft.

Sand Sil 3502

Gas _____

Oil _____

Total Depth 3515

PRODUCTION

1st 24 hrs. Nat. _____

1st 24 hrs. after shot _____

Gas _____ Cu. Ft.

Dry Hole _____

Abandoned _____

Date

10-17-35 192ORVAL MANN SCHRECK
Scout