


DX 78-1

Harvey KANSAS

Section 14 Township 22 Range 2 W

Well No. # 3 Sperling

Company Texas Company

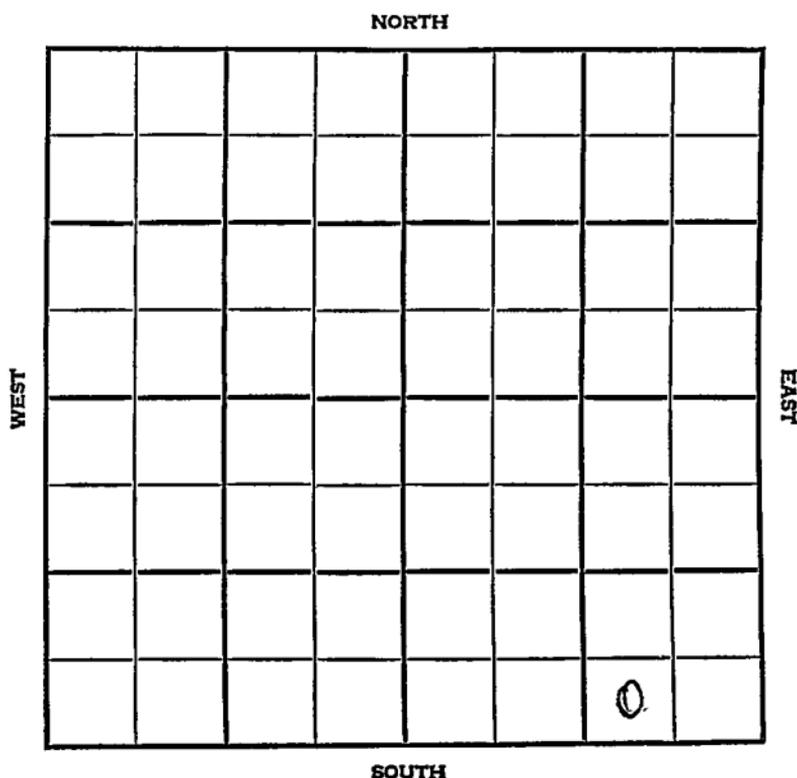

Harvey KANSAS

SEC.	TWP.	R.
14	22	2W

WELL NO. _____
 COMPANY 3 Sperling FARM

CONTRACTOR Texas Company


Stickle Drlg.
 Sperling Pool

_____ Ft. from N. Line

330 _____ Ft. from S. Line

990 _____ Ft. from E. Line

_____ Ft. from W. Line

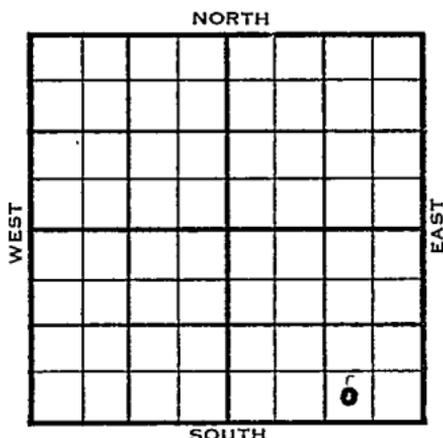

SW SE SE

1954	ELEVATION 1466	REPORT
------	-------------------	--------

10/20 Spud 10-14-54
 10" @ 198'
 Drlg. 1980'

11/10 Spud 10-14-54
 Oil Well
 TD 3273'
 10" @ 198'
 Top 2010', Lans 2315' Miss 2907'
 DST 2909'-35' failed.
 DST 2892'-2935' opn 1 hr, gas in 8 min
 450,000' cfg. rec 150' mud, 880#
 Hunton 3240'
 TD 3273'
 7" @ 3260'
 CO to 3273'
 FU 1200' oil P/ 2I bo 1 hr.
 P/ 119 bo 8 hr.
 Comp 358 bopd.

COMPLETED

