


Section 14 Township 22 Range 16 W

Well No. # 1 Scharz

Company Fred B. Anschutz

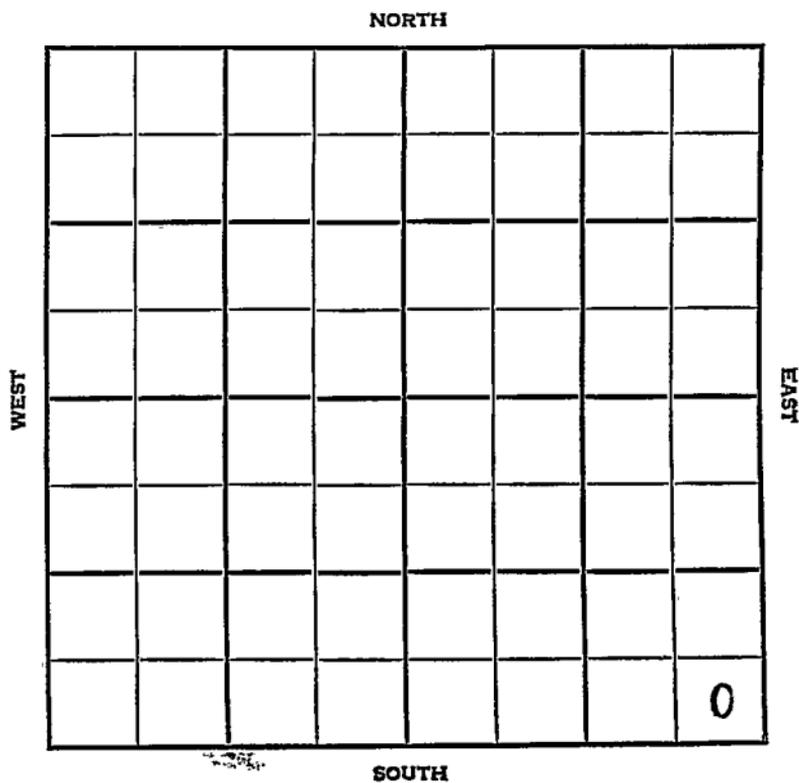

Pawnee KANSAS

SEC.	TWP.	R.
14	22	16W


WELL NO. 1 Schartz FARM

COMPANY Fred B. Anschutz

CONTRACTOR Co. Tools

Wildcat

_____ Ft. from N. Line
 330 _____ Ft. from S. Line
 330 _____ Ft. from E. Line
 _____ Ft. from W. Line

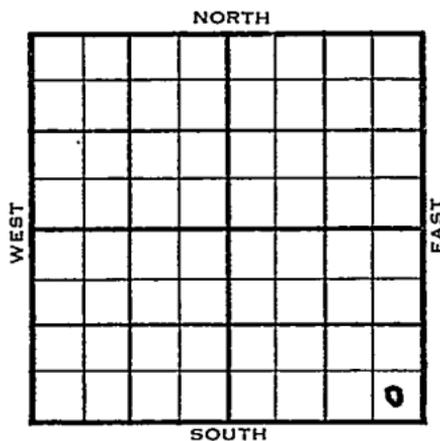

SE SE SE
 Lion & Sunray DHM

	ELEVATION	REPORT
1955	2013'	
2/16	Spud 2-11-55 8" @ 253'	
4/13	Drlg. 2575'	
	Spud 2-11-55 - Gas Well	
	TD 4063'	
	8" @ 253'	
	Heeb. 3458', Tor. 3475', Br lime 3567'	
	Lans. 3576'	
	DST 3610-23', opn 1 hr., rec. 420'	
	gas, 20' gcm, 640#	
	Ch. cong. 3958', Sh. Cong. 3883'	
	DST 3958-78', opn 1 hr., rec. 30' mud,	
	Simp. 3990', Arb. 4020'	
	DST 4023-32', opn 1 hr., gas in 5",	
	25,000 cfg, 40' gc?m, 1200#	
	DST 4027-63, opn 1 hr., 3,310,000	
	cfg, 110' oil, 350' sul wtr, 1200#	
	TD 4063'	
	5" @ 4062', CO	
	13/4043-45, B/15 gmo & wtr,	
	FU 1250' fluid	
	B/20 go 59 gw	
	C/13 gfph 50% muddy oil, 500A, SI 13	
	hrs.	
	Comp. SI Gas Well	
	3,690,000 cfgpd	

COMPLETED


County Pawnee State Kansas

Sec. 14 (Blk. Twp.) 22 (Sur. Rge.) 16W Map No.

Operator Fred B. Anschutz

Well No. 1 Farm Schartz

Elev. 2013 Location SE SE SE

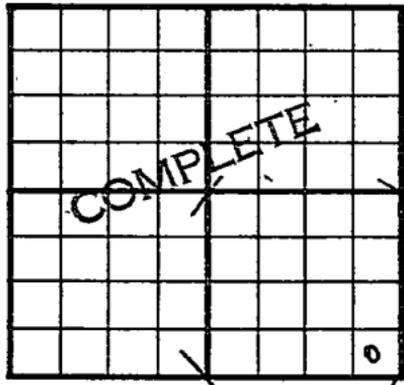

330 Ft. From S Line SE

330 Ft. From E Line Quarter

Ist. Report

Completion APR 13 1955

Remarks Wildcat

Co. tools

Spudding Date 2-11-55

Drlg. Data Gas well TD 4063

8" @ 253 Heeb. 3458 Tor. 3475

Br. lime 3567 Lans. 3576 DST 3610-23

open 1 hr. Rec. 420' gas 20' gcm

640# Ch. Cong. 3958 Sh. Cong. 3883

DST 3958-78 open 1 hr. Rec. 30' mud

Simp. 3990 Arb. 4020 DST 4023-32

open 1 hr. gas in 5 min. 25,000 cfg

40' gcm 1200# DST 4027-63 open 1 hr.

3,310,000 cfg 110' oil 350' sul. wtr.

1200# TD 4063 5" @ 4062 CO

13/ 4043-45 B/ 15 gmo & wtr. FU 1250' fluid

B/ 20 go 59 gw B/ 13 gfph 50% muddy oil

500 A SI 13 hr.

Comp. SI gas well 3,690,000 cfgpd

FABEN GILSTRAF