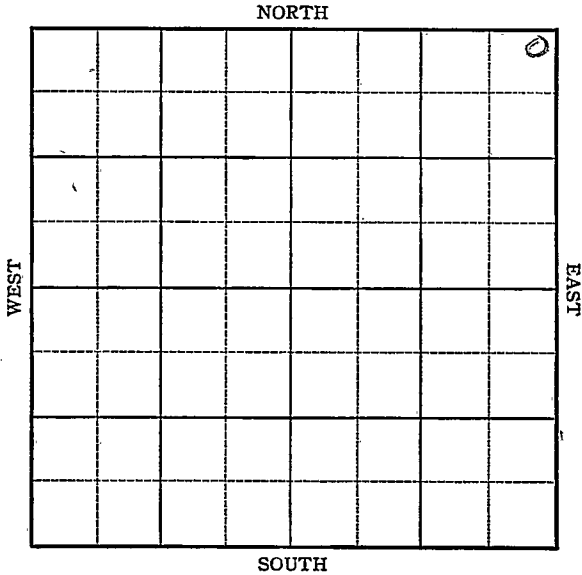


KANSAS

Pawnee

FORM 51 5M 11-44 PETROL

Section 14 Township 22 Range 19WWell No. 1 OsgoodCompany Continental

KANSAS

Pawnee

Sec. 14 Twp. 22 R. 19-W

Well No. #1 Osgood Farm

Continental Company


330 Ft. from N. Line

 Ft. from S. Line

330 Ft. from E. Line

 Ft. from W. Line

NE/c Elev. 2076

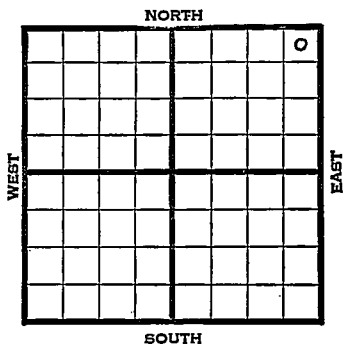

1945

R E P O R T

8/1 Derrick
8/8 15" @ 250
Drlg. 1095
8/15 Anhy. 1165
9" @ 1188
Drlg. 2690
8/22 Drlg. 3730
8/29 Lans 3741
Chat 4276
Viola 4431
Simp 4551
Arb. 4583
TD 4607 No shows
9/5 Arb. 4583
TD 4615'

ABANDONED

KANSAS

Kansas


Pool Name WildcatMap No. 40 Sec. 14 Twp. 22 R. 19WWell No. 1 OsgoodContinental

Company

FIRST REPORT

Contractor

NE/c

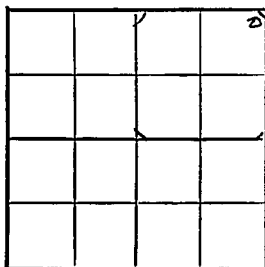SECTION PLAT330 Ft. from N. Line

Ft. from S. Line

330 Ft. from E. Line

Ft. from W. Line

Pawnee County

Location

Rig up

Drilling and Remarks:
derrick**RECORD**

Cased _____ in., _____ ft.

Sand _____

Gas _____

Oil _____

Total Depth _____

PRODUCTION

1st 24 hrs. Nat. _____

1st 24 hrs. after shot _____

Gas _____ Cu. Ft.

Dry Hole _____

Abandoned _____

Date

AUG 1 1945S. J. LEWIS

Scout

KANSAS

Kansas Pool Name WildcatMap No. 80 Sec. 14 Twp. 22 R. 19WWell No. 1 OsgoodContinental CompanyABANDONED Contractor

NE/c

E12076
SECTION PLAT330 Ft. from N. Line Ft. from S. Line330 Ft. from E. Line Ft. from W. Line

			0

Pawnee County

Location _____

Rig up _____

Drilling and Remarks:

CR #4583

RECORD

Cased _____ in., _____ ft.

Sand _____

Gas _____

Oil _____

Total Depth 4615

PRODUCTION

1st 24 hrs. Nat. _____

1st 24 hrs. after shot _____

Gas _____ Cu. Ft.

Dry Hole _____

Abandoned _____

Date

SEP 5 1945 19S. J. LEWIS Scout