


Hodgeman

KANSAS

SECTION 14 TOWNSHIP 22 RANGE 25W

WELL NO. #1 Beltz

COMPANY Kewanee

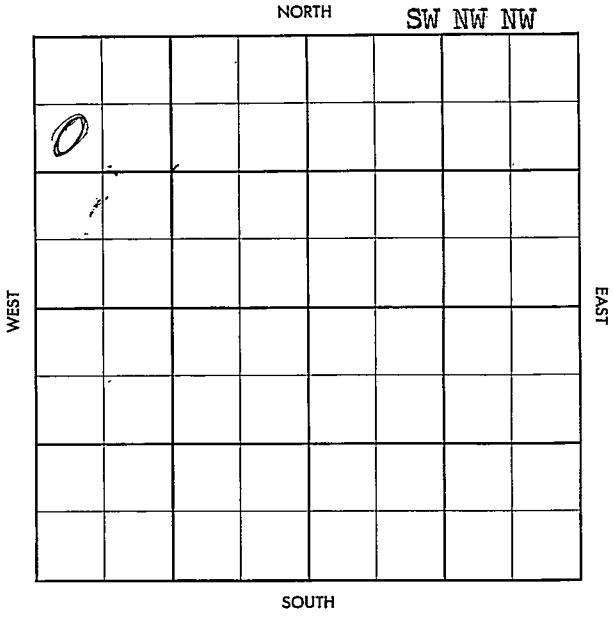

County Hodgeman Elev. \_\_\_\_\_  
 Sec. 11 Twp. 22 Rge. 25W  
 Company Kewanee  
 FarmName Beltz No. I

TOPS	DEPTH	LOG	DATUM
Anh.			
Tp.			
H.			
Tr.			
Dg.			
Bl.			
L.			
K.C.			
B.K.C.			
Ce.			
C.			
M.			
M.			
K.			
Mz.			
Mo.			
V.			
S.			
S.			
A.			
R.			
Pe.			
G.			
T.D.			

Loc. in Sec. SW NW NW  
987' NL  
330' WL  
 Geol. \_\_\_\_\_  
 Contr. Graham-Michael

Pool Hallet outpos.

		MAY 22 1957

FIRST REPORT

Date Comm. MIR

*[Handwritten signature]*

Co. \_\_\_\_\_  
 No. \_\_\_\_\_  
 Sec. \_\_\_\_\_  
 T. \_\_\_\_\_  
 R. \_\_\_\_\_

County Hodgeman Elev. 2503  
 Sec. 11 Twp. 22 Rge. 25W  
 Company Kewanee  
 FarmName Beltz No. 1

TOPS	DEPTH	LOG	DATUM	Loc. in Sec.
Ank.				SW NW NW
Tr.				
H.	3900			987' NL
Tr.	3916			
Dg.	3937			330' WL
Bl.				
L.	3948			
K.C.				Geol.
B.K.C.	4351			Contr
C.	Marm 4379			Graham-Michael
C.	4585			
M.	4600			Pool
M.				Hallet outpos
K.				
Mz.				
Mo.				
V.				
S.				
S.				
A.				
R.				
PE.				
G.				
TD.	4705			COMPLETE OCT 2 '57

Date Comm. M I R MAY 29 '57 5-22-57 85/f  
563/220 3460 JUN 5 '57  
ord 4598-4608 Full rec.  
ord 4608 1/2-14 Full rec.  
CR9 @ 4614 JUN 12 '57 DST 4597-  
4608 ord 1hr rec 180' Free  
oil + 243' MCO BHP 570.145  
DST-4608-36 1hr rec 260'  
clean oil + 240' oil Fro 999

270/30" 5 1/2 4704 wact

JUN 19 '57 JUN 26 '57 CO 4674 16/

4611-15 \$ 99.1 GO + 3.3

GW in 1 hr 1/4 \$ 9.25

DO 2 hrs 20/4602-07 1/4

\$ 39.44 BO in 7 hrs 20/0

wtr 1/4 \$ 216 BO

290 BS EW 16 1/2 hrs av.

13 Boph TGR JUL 3 '57 POP

JUL 10 '57 JUL 17 '57 JUL 24 '57 JUL 31 '57 X AUG 8 '57

AUG 14 '57 AUG 21 '57 AUG 28 '57 SEP 4 '57 SEP 11 '57

SEP 18 '57 SEP 25 '57 OCT 2 '57

269 Boph + w

Miss 4602-15