


Hodgeman

KANSAS

SECTION 14 TOWNSHIP 22S RANGE 25W

WELL NO. #2 Beltz

COMPANY Kewanee Oil

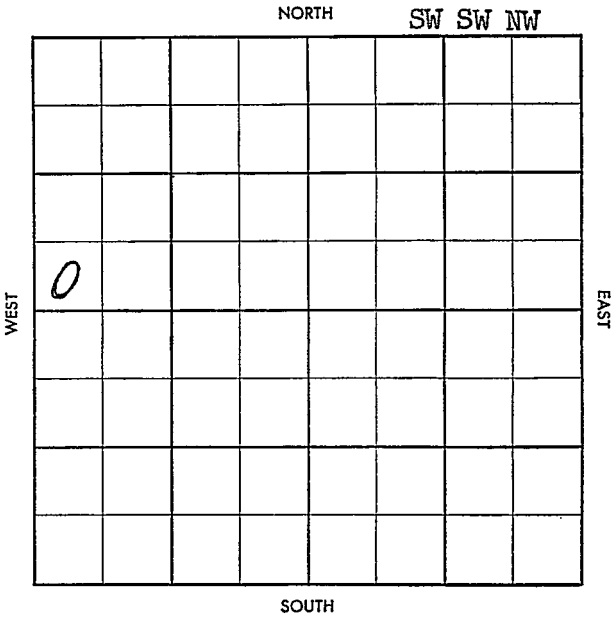


45

S-513-B

County Hodgeman Elev. \_\_\_\_\_  
 Sec. 14 Twp. 22 Rge. 25W  
 Company Kewanee Oil  
 Farm Name Beltz No. 2

TOPS	DEPTH	LOG	DATUM
Anh.			
Tp.			
H.			
Tr.			
Dg.			
B.L.			
L.			
K.C.			
B.K.C.			
Ce.			
C.			
M.			
M.			
K.			
Mz.			
Mq.			
V.			
S.			
S.			
A.			
R.			
Pf.			
G.			
T.D.			

Loc. in Sec. \_\_\_\_\_  
SW SW NW  
 Geol. \_\_\_\_\_  
 Contr. Graham-  
Michaelis  
 Pool \_\_\_\_\_  
Hallett

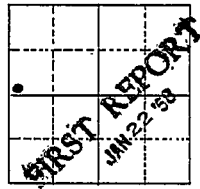

Date Comm. \_\_\_\_\_  
Location  
 \_\_\_\_\_  
 \_\_\_\_\_  
 \_\_\_\_\_  
 \_\_\_\_\_  
 \_\_\_\_\_  
 \_\_\_\_\_

Co.  
Lse.  
No.  
Sec.  
T.  
R.

County Hodgeman Elev. 2510  
 Sec. 14 Twp. 22 Rge. 25W  
 Farm Name Beltz No. 2

TOPS	DEPTH	LOG	DATUM
Anh.			
Tp.			
H.		<u>3912</u>	
Tr.		<u>3929</u>	
Dg.		<u>3951</u>	
B.L.			
L.		<u>3964</u>	
K.C.			
B.K.C.		<u>4370</u>	
Ce. <u>MAN</u>		<u>4400</u>	
C.		<u>4602</u>	
M.		<u>4618</u>	
M.			
K.			
Mz.			
Mq.			
V.			
S.			
S.			
A.			
R.			
Pf.			
G.			
T.D.	<u>4715</u>		

Loc. in Sec. SW SW 14

Geol. Graham-  
 Contr. Michaelis

Pool Hallett

MAR 12 '58  
**ABANDONED**

Date Comm. 2-24-58

Location MAN FEB FEB 12 '58 FEB 19 '58

8" 5' 53" / 350 84017

MAR 2 '58 DST 4603-36 60" 85'M

BHP 170/45 DST (AT) 4603-36

60' 55" HCM BHP 90/30

DBA

Co.  
 Lse.  
 No.  
 Sec.  
 T.  
 R.