

Finney

KANSAS


SECTION 14 TOWNSHIP 22S RANGE 32W

WELL NO. #1 B. Preisser

COMPANY Texas-Champlin-Skelly - Sunray

NORTH

C NW/4

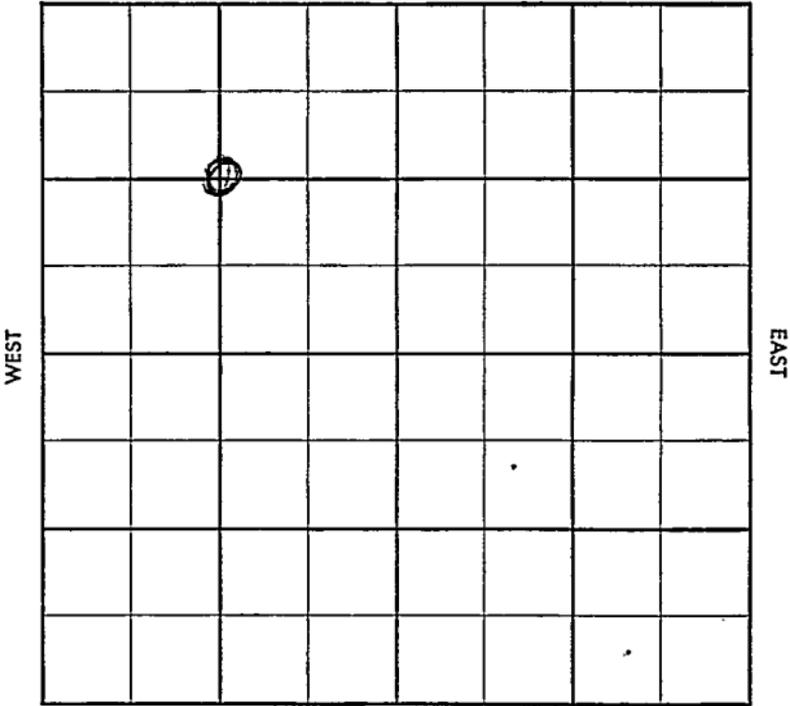

SOUTH

SEC. 14 SWP. R. 22 S 32 W

WELL NO.


1 B. Preisser Gas Unit FARM

COMPANY (Development-OBOC)

Texas, Champlin, Skelly & SDX

CONTRACTOR

Hugoton Gas Field Area

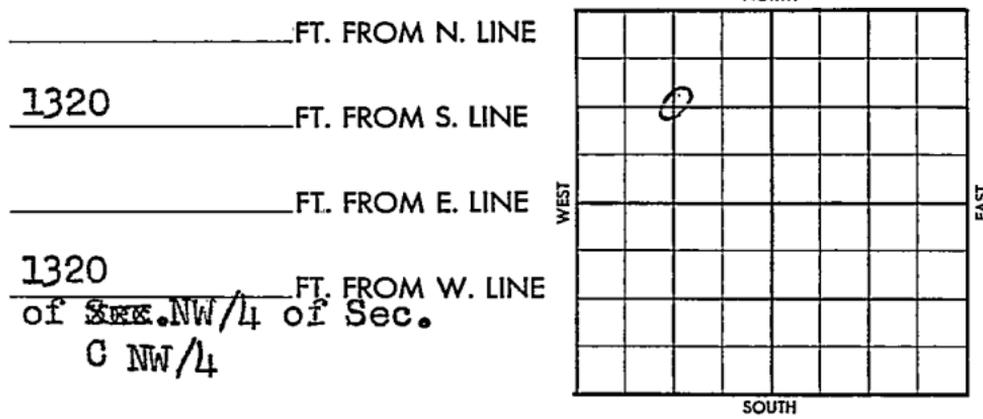

 1320 FT. FROM S. LINE
 1320 FT. FROM W. LINE
 of ~~Sec.~~ NW/4 of Sec.
 C NW/4

DATE	ELEVATION REPORT
1958	2700' Permian Lime Test
5/26	MIRT (FR T _{kt})
6/4	" (WH Wkly Report)
6/10	Soudded 6-3-58 8-5/8" @ 530'w/350 TD 532' WOC (DR#112)
6/11	Drlg. 1519'
6/12	Ran log. 5" @ 2766/600 WOCT Log tops: Herr 2668', Krid 2694', L. Krid. 2718', Win. 2754' (WH Wkly Rpt)
6/13	TD 2766' NR
6/16	" "
6/17	TD 2766'. Drlg. plug.
6/18	TD 2766'. Swbg. acidized perfs. 2756-2760'
6/19	TD 2766'. CO to 2764'. Perf 16/2756-60 500 Acid. Ga 377 MCFG. Fraced. No increase in gas + 72 GSWPH. Sqzd. Perf 32/2697-2705'. 500 Acid. Ga 128 MCFG in 4 hrs. Fraced. Tested 2,500 MCFG. (WH-Wkly Drlg. Rpt)
6/20	TD 2766'. Flowing from fraced perfs.
6/23	TD 2766'. Acidized perfs 2697-2705'
6/24	TD 2766'. Flowed 2500 MCF. Perfs 2697-2705' Krider Zone. Complete (DR#122)

Twp. X Pool X
 Co. X Foot

S-513-B

County Finney Elev. _____
 Sec. 14 Twp. 22 Rge. 32W
 Company Texas - Champlin - Skelly - Sunray
 Farm Name B. Preisser No. 1

TOPS	DEPTH	LOG	DATUM
Anh.			
Tp.			
H.			
Tr.			
Dg.			
B.L.			
L.			
K.C.			
B.K.C.			
Ce.			
C.			
M.			
M.			
K.			
Mz.			
Mq.			
V.			
S.			
S.			
A.			
R.			
Pf.			
G.			
T.D.			

Loc. in Sec. C NW/4
 Geol. _____
 Contr. _____
 Pool Hugoton

FIRST REPORT
 MAY 26 58

Date Comm. _____

Location

Co.
Lse.
No.
Sec.
T.
R.

Twp. ~~X~~ Pool. ~~X~~

Co. ~~X~~ Facet. ~~X~~

5-513-B

County Finney Elev. 2952 DF 2955 RB
14 22 Rge. 32W
TEXAS - Champ 2 p - Skelly - Sunny
B. Preisser No. J

TOPS	DEPTH	LOG	DATUM
Anh. <u>Herr</u>		<u>2668</u>	
Tp. <u>U kvd</u>		<u>2694</u>	
H. <u>L kvd</u>		<u>2718</u>	
Tr. <u>win</u>		<u>2754</u>	
Dg.			
B.L.			
L.			
K.C.			
B.K.C.			
Ce.			
C.			
M.			
M.			
K.			
Mz.			
Mq.			
V.			
S.			
S.			
A.			
R.			
Pf.			
G.			
T.D.	<u>2766</u>		

Loc. in Sec. 3 17 1/2

Geol.

Contr.

Pool Fugoton

COMPLETE

JUN 25 58

Date Comm. 6-3-58
 Location JUN 3 58 MIRT JUN 11 58 9"

530/350 fan log 5" 2766/600
WCT JUN 18 58 CO 2764 16/2756-60

ga 377 maf free 4x4 no more
in ga + 72 g sulph 50 32/2697
2705 ga 128 maf + Ld 4hrs
free 4x4 2,500 maf + Ld
JUN 25 58 2 1/2 Bls 2,500 maf no pressures

PB 2764

⋈