

Kearny

DX 78-1


KANSAS

Section 14 Township 22 Range 36W

Well No. #1 Dienst

Company Kansas Natural Gas

NORTH

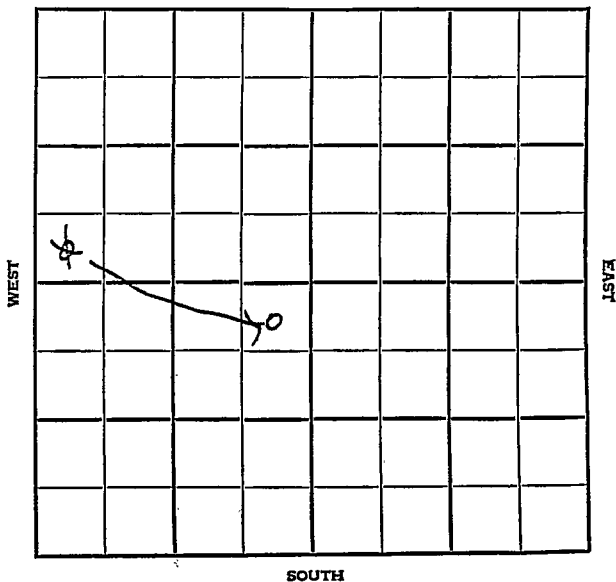

Kearny

KANSAS

SEC.	TWP.	R.
14	22	36 W ✓

WELL NO.

1 Dienst

FARM

COMPANY

Kansas Natural Gas

CONTRACTOR

B & R Drlg.

Hugoton Pool


330 Ft. from N. Line

330 Ft. from S. Line

330 Ft. from E. Line

330 Ft. from W. Line

NE NE SW
~~SW SW NW~~

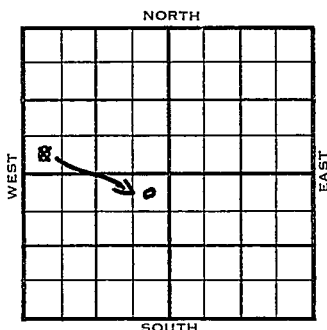


Carter Farmout

	ELEVATION	REPORT
1954	3121'	

5/12 Spud 5-5-54
 8" @ 30 Her. 2586 Kri. 2600
 Win. 2652' 5" @ 2672 TD 2672

6/2 Spud 5-5-54 Gas well TD 2672
 8" @ 30 Her. 2586 Kri. 2600
 Win. 2652 5" @ 2672 TD 2672
 CO to 2672 84/2648-62 500 A
 SP 2630 120/2588-2618 1000 A
 21,000 gas. 2000 A 49,000 gas.
 Comp. 1,903,000 gas.

COMPLETED

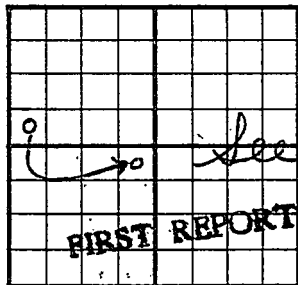County Kearny State KansasSec. 14 (Blk. Twp.) 22 (Sur. Rge.) 36W Map No.Operator Kansas Natural GasWell No. 1 Farm DienstElev. Location SW SW NW330 Ft. From S Line NW330 Ft. From W Line QuarterIst. Report MAY 1 2 1954Completion correctionRemarks Carter farmoutB & R Drlg. - Contr.Spudding Date 5-5-54Drlg. Data Hugoton Pool8" @ 30 Her. 2586 Kri. 2600Win. 2652 5" @ 2672 TD 2672

J. G. McGEHEE

Kans200

Map No. _____ Sec. 14 Twp. 22 R. 36W

Well No. 1 Dienst

Kansas Natural Gas Company

CORRECTION Contractor

NE NE SW


SECTION PLAT

330 Ft. from N. Line

_____ Ft. from S. Line

330 Ft. from E. Line

_____ Ft. from W. Line

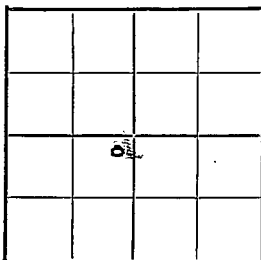

Kearny County

Location _____

Rig up 1 YAM

Drilling and Remarks:

Reported
SW SW NW

RECORD

Cased _____ in., _____ ft.

Sand _____

Gas _____

Oil _____

Total Depth _____

PRODUCTION

1st 24 hrs. Nat. _____

1st 24 hrs. after shot _____

Gas _____ Cu. Ft.

Dry Hole _____

Abandoned _____

Date

MAY 12 1958 19

J. G. McGEHEE Scout

County Kearny State Kansas
 Sec. 14 (Blk. 22) (Sur. 36W) Map No. 36W
 Operator Kansas Natural Gas
 Well No. 1 Farm Dienst
 Elev. 3121 Location NE NE SW

COMPLETE

330 Ft. From N Line SW
 330 Ft. From E Line Quarter
 1st. Report JUN 2 1954
 Completion JUN 2 1954
 Remarks Hugoton Pool
B & R Drlg. - Contr.
 Spudding Date 5-5-54

Drlg. Data Gas well TD 2672
8" @ 30 Her. 2586 Kri. 2600
Win. 2652 5" @ 2672 TD 2672 CO to 2672
84/ 2648-62 500 A SP 2630 120/ 2588-
2618 1000 A 21,000 gas 2000 A
49,000 gas Comp. 1,903,000 gas