

GREAT BEND OIL PRODUCERS

CRANE LEASE
NE ¼, SECTION 11, T22S, R15W
PAWNEE COUNTY, KANSAS

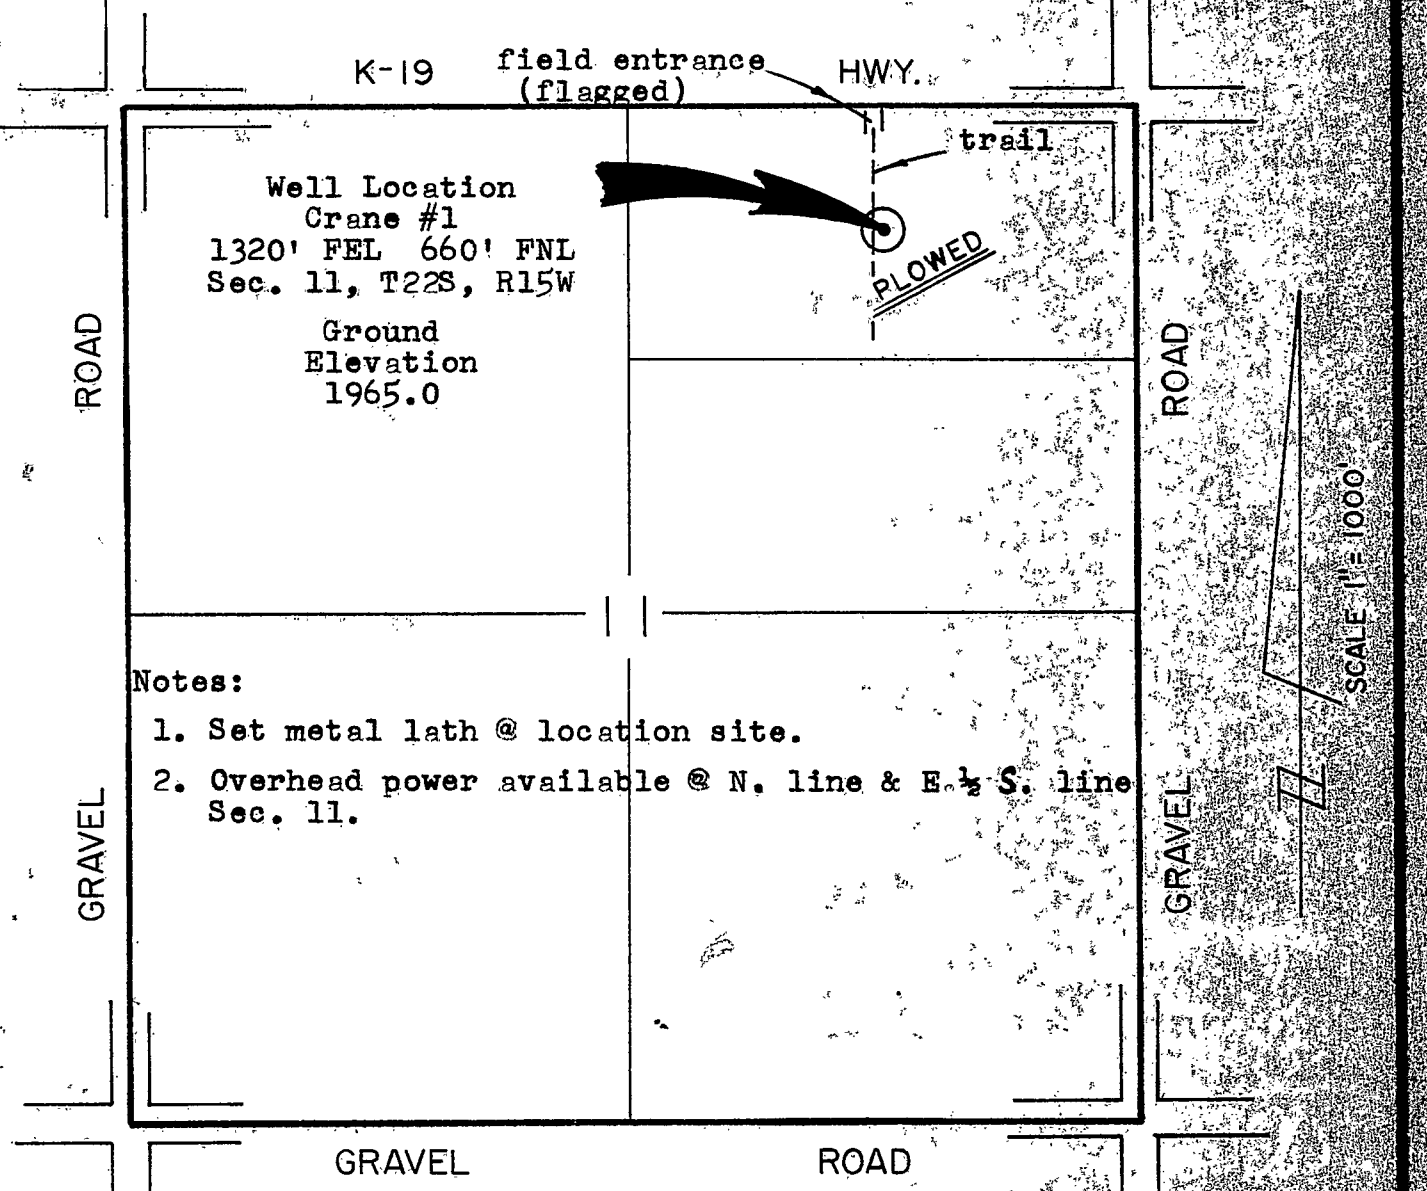

Notes:

1. Set metal lath @ location site.
2. Overhead power available @ N. line & E. ½ S. line Sec. 11.

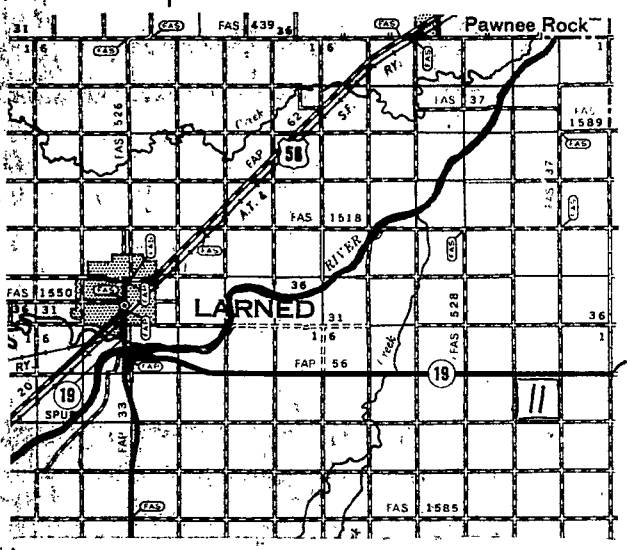

RANDY E. ANDERSON
REGISTERED
LS-802
KANSAS
LAND SURVEYOR

Randy Anderson
Randy E. Anderson, R.L.S. 802

Date March 16, 1983

CENTRAL KANSAS SURVEYING & MAPPING (316) 792-5754


Well
Oil Wells
BM Ray
BM 1951
Well
WELL LOCATION
Wells
Well
34
35
36
31
1
10
11
12
7
19