


KANSAS

Stafford

Section 15 Township 22 Range 13W

Well No. 3 Howard

Company Franco Central
Kenilworth

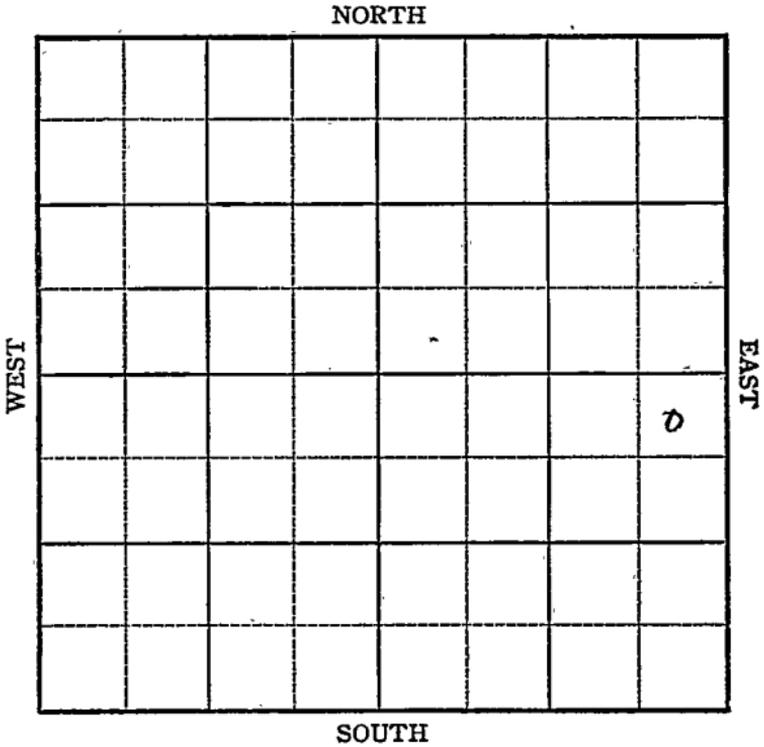

KANSAS Stafford

Sec. 15 Twp. 22 R. 13W ✓

Well No. #3 Howard Farm

Franco Central Company

Kenilworth Pool


NORTH

330' Ft. from N. Line

Ft. from S. Line

330' Ft. from E. Line

Ft. from W. Line

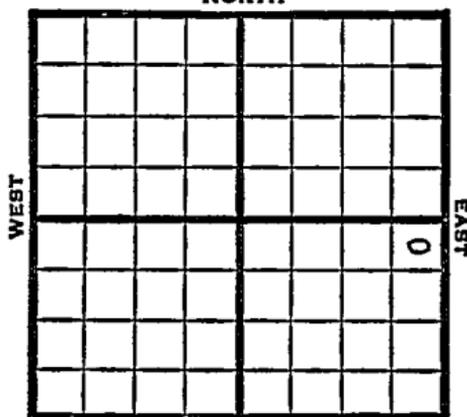

SOUTH

NE SE

1949 Elev 1893' REPORT

- 3/30 Location
- 4/6 RUR
- 4/12 8" @ 270'
Drlg. 3435'
- 4/20 Lansing 3394'
Viola 3688'
Simpson 3734'
Arbuckle 3789'
TD 3795'
5" @ 3790'
820 oil - 3 hrs.
- 4/27 1000 acid
Pump 15 bbls oil PH
- 5/4 "
- 5/11 TD 3795'
Arb. 3789'
5" @ 3790'
1000 acid
Pump 599 Oil Pot
28°nGr.
Comp

COMPLETED

Map No. _____ Sec. 15 Twp. 22 R. 13W

Well No. 3 Howard

_____ Franco Central _____ Company

_____ FIRST REPORT _____ Contractor

NE SE

SECTION PLAT

330 Ft. from N. Line

_____ Ft. from S. Line

330 Ft. from E. Line

_____ Ft. from W. Line

			o

Stafford County

Location X

Rig up _____

Drilling and Remarks:

RECORD

Cased _____ in., _____ ft.

Sand _____

Gas _____

Oil _____

Total Depth _____

PRODUCTION

1st 24 hrs. Nat. _____

1st 24 hrs. after shot _____

Gas _____ Cu. Ft.

Dry Hole _____

Abandoned _____

Date

MAR 30 1949 19

S. J. LEWIS Scout

Map No. K82 Sec. 15 Twp. 22 R. 13W

Well No. 3 Howard

Franco Central Company

COMPLETE Contractor

NE SE

E 11 1993
SECTION PLAT

330 Ft. from N. Line

_____ Ft. from S. Line

330 Ft. from E. Line

_____ Ft. from W. Line

			o

Stafford County

Location _____

Rig up _____

Drilling and Remarks:

CR 3789

5" @ 3790

10000 cu ft

Prod 599 oil Pt

25° SW

RECORD

Cased _____ in., _____ ft.

Sand _____

Gas _____

Oil _____

Total Depth 2295'

PRODUCTION

1st 24 hrs. Nat. _____

1st 24 hrs. after shot _____

Gas _____ Cu. Ft.

Dry Hole _____

Abandoned _____

Date

MAY 11 1949 19

S. J. LEWIS Scout