

KANSAS

Stafford

FORM 51 IOM 12-46 PETROL

Section 15 Township 22 Range 13-W

Well No. 1 Moon

Company E. Adair

Kenilworth

NORTH

		1					
		0					

WEST

EAST

SOUTH

Sec. 15 Twp. 22 R. 13W

Well No. #1 Moon Farm \_\_\_\_\_

E. Adair Company \_\_\_\_\_

Kenilworth


\_\_\_\_\_ Ft. from N. Line

330 Ft. from S. Line

\_\_\_\_\_ Ft. from E. Line

990 Ft. from W. Line

SW SE NW

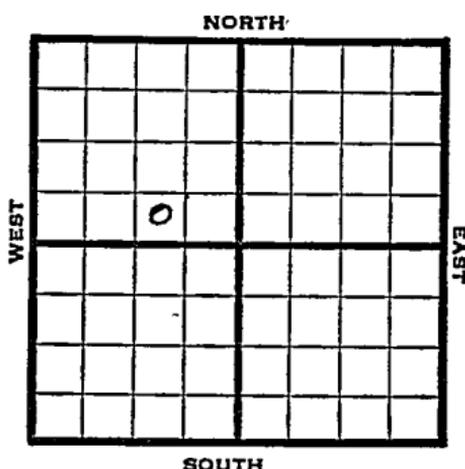

1947 REPORT

- 9/24 8" @ 284'  
Anhy. 750'  
Drlg. 2870'
- 10/1 Lansing 3396'  
Arbuckle 3789'  
TD 3792'  
5" @ 3790'  
RUST
- 10/8 "
- 10/15 TD 3792'
- 10/22 "
- 10/29 PB 3700'  
36 shots 3548-60  
Acid 1000  
Swb 5 bbls oil PH
- 11/5 Plug 3522 - 42 shots 3511-21-  
1500 acid  
Swab 38 bbls oil PH
- 11/12 "
- 11/19 "
- 11/25 "
- 12/3 "
- 12/10 "

1947

12/17 Arbuckle 3789'  
5" @ 3790'  
PB 3700  
Lansing 3396  
Perf Lansing  
2500 Acid  
Pump 47 Pot  
TD 3802'  
Gravity 38

**COMPLETED**

Map No. \_\_\_\_\_ Sec. 15 Twp. 22 R. 13W

Well No. 1 Moon

E. Adair Company

**FIRST REPORT**

Contractor

SW SE NW


**SECTION PLAT**

\_\_\_\_\_ Ft. from N. Line

330 Ft. from S. Line

\_\_\_\_\_ Ft. from E. Line

990 Ft. from W. Line

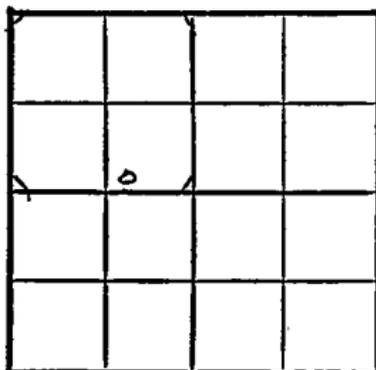

Stafford County

Location \_\_\_\_\_

Rig up \_\_\_\_\_

Drilling and Remarks:

8" @ 284

anhy 750

dr lg. 2870

**RECORD**

Cased \_\_\_\_\_ in., \_\_\_\_\_ ft.

Sand \_\_\_\_\_

Gas \_\_\_\_\_

Oil \_\_\_\_\_

Total Depth \_\_\_\_\_

**PRODUCTION**

1st 24 hrs. Nat. \_\_\_\_\_

1st 24 hrs. after shot \_\_\_\_\_

Gas \_\_\_\_\_ Cu. Ft.

Dry Hole \_\_\_\_\_

Abandoned \_\_\_\_\_

Date

SEP 24 1947 19

S. J. LEWIS Scout

