

KANSAS

Stafford

Sec. 15 Twp. 22 R. 13W

Well No. #2 Moon Farm

Franco Central Company

Kenilworth Pool


_____ Ft. from N. Line

990' Ft. from S. Line

_____ Ft. from E. Line

990' Ft. from W. Line

NE SW NW

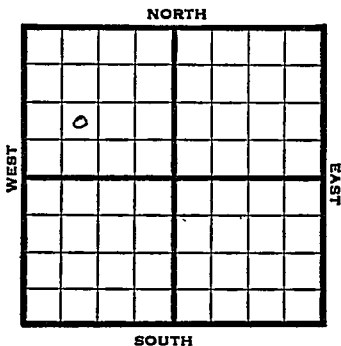

1948 Elev. 1899' REPORT

6/23 8" @ 285'
Drlg. 907'

6/29 Lansing 3411
Drlg 3585

7/8 Lansing 3411'
Arbuckle 3828'
TD 3855'

ABANDONED

Map No. _____ Sec. 15 Twp. 22 R. 13W

Well No. 2 Moon

Franco Central Company

FIRST REPORT Contractor

NE SW NW

SECTION PLAT

_____ Ft. from N. Line

990 Ft. from S. Line

_____ Ft. from E. Line

990 Ft. from W. Line

o			

Stafford County

Location _____

Rig up _____

Drilling and Remarks: _____

8" @ 285

drlg. 907

RECORD

Cased _____ in., _____ ft.

Sand _____

Gas _____

Oil _____

Total Depth _____

PRODUCTION

1st 24 hrs. Nat. _____

1st 24 hrs. after shot _____

Gas _____ Cu. Ft.

Dry Hole _____

Abandoned _____

Date

JUN 23 1948 19_____

S. J. LEWIS Scout

Map No. 82 Sec. 15 Twp. 22 R. 13W

Well No. 2 Moon

Franco Central Company

ABANDONED

Contractor

NE SW NW

E 11899

SECTION PLAT

_____ Ft. from N. Line

990 Ft. from S. Line

_____ Ft. from E. Line

990 Ft. from W. Line

0			

Stafford County

Location _____

Rig up _____

Drilling and Remarks:

Lease 3411

Ac 73828

RECORD

Cased _____ in., _____ ft.

Sand _____

Gas _____

Oil _____

Total Depth 3855

PRODUCTION

1st 24 hrs. Nat. _____

1st 24 hrs. after shot _____

Gas _____ Cu. Ft.

Dry Hole _____

Abandoned _____

Date

JUL 8 1948 19

S. J. LEWIS Scout