


Section 15 Township 22 Range 13W

Well No. #2 Oche1

Company Phillips

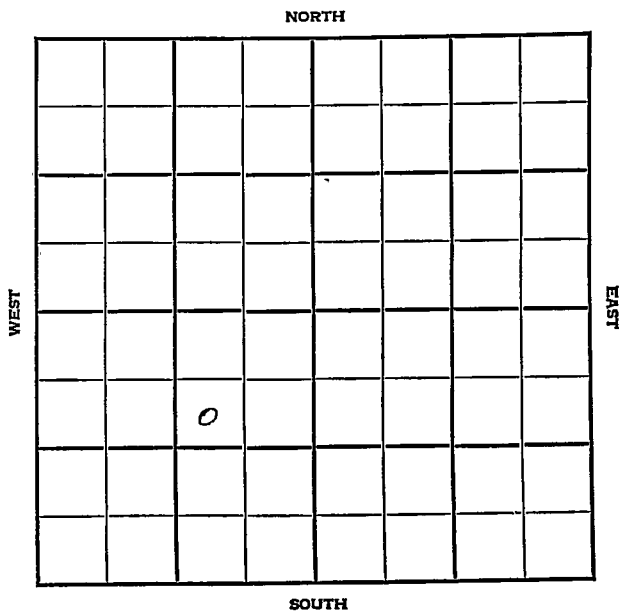

KANSAS

Stafford

Sec. 15 Twp. 22 R. 13-W

Well No. #2 Ochei Farm

Phillips Company

Kenilworth Pool


990' Ft. from N. Line

\_\_\_\_\_ Ft. from S. Line

990' Ft. from E. Line

\_\_\_\_\_ Ft. from W. Line

SW NE SW

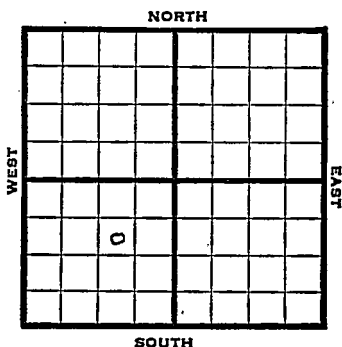

1947

Elev. 1892' REPORT

11/25

Location

12/3

8" @ 451'  
Drlg. 1922'

12/10

Lansing 3390'  
Drlg. 3420'

12/17

Viola 3703'  
Simp. 3746'  
Arbuckle 3808'  
TD 3811'  
5" @ 3808'  
RUST

12/30

TD 3812' - 500 acid

1948

1/7

"

1/14

"

1/21

Arb. 3808'  
5" @ 3808'  
500 acid  
Pump 280 oil / 40 W pot  
29.0 Gr.  
TD 3812'

**COMPLETED**

Map No. \_\_\_\_\_ Sec. 15 Twp. 22 R. 13W

Well No. 2 Ochel

Phillips Company

FIRST REPORT Contractor

SW NE SW

990 Ft. from N. Line

\_\_\_\_\_ Ft. from S. Line

990 Ft. from E. Line

\_\_\_\_\_ Ft. from W. Line

SECTION PLAT


Stafford County

Location X

Rig up

Drilling and Remarks:

RECORD

Cased \_\_\_\_\_ in., \_\_\_\_\_ ft.

Sand \_\_\_\_\_

Gas \_\_\_\_\_

Oil \_\_\_\_\_

Total Depth \_\_\_\_\_

PRODUCTION

1st 24 hrs. Nat. \_\_\_\_\_

1st 24 hrs. after shot \_\_\_\_\_

Gas \_\_\_\_\_ Cu. Ft.

Dry Hole \_\_\_\_\_

Abandoned \_\_\_\_\_

Date

NOV 25 1947 19

S. I. LEWIS Scout

Map No. 82 Sec. 15 Twp. 22 R. 13W

Well No. 2 Ochel

Phillips Company

**COMPLETE**

Contractor

SW NE SW

E. 11892  
**SECTION PLAT**

990 Ft. from N. Line

\_\_\_\_\_ Ft. from S. Line

990 Ft. from E. Line

\_\_\_\_\_ Ft. from W. Line


Stafford County

**RECORD**

Location \_\_\_\_\_

Cased \_\_\_\_\_ in., \_\_\_\_\_ ft.

Rig up \_\_\_\_\_

Sand \_\_\_\_\_

Drilling and Remarks:

Gas \_\_\_\_\_

Oil

Total Depth 3812

**PRODUCTION**

1st 24 hrs. Nat. \_\_\_\_\_

1st 24 hrs. after shot \_\_\_\_\_

Gas \_\_\_\_\_ Cu. Ft.

Dry Hole \_\_\_\_\_

Abandoned \_\_\_\_\_

*CR 13808*  
*5" @ 3808*  
*5000000*  
*Pump 2800 ft*  
*40W02*  
*29 3/4*

Date

JAN 21 1948

19

S. J. LEWIS

Scout