


Section 15 Township 22 Range 13 W

Well No. # 1 Soeken (B)

Company Petroleum Inc.

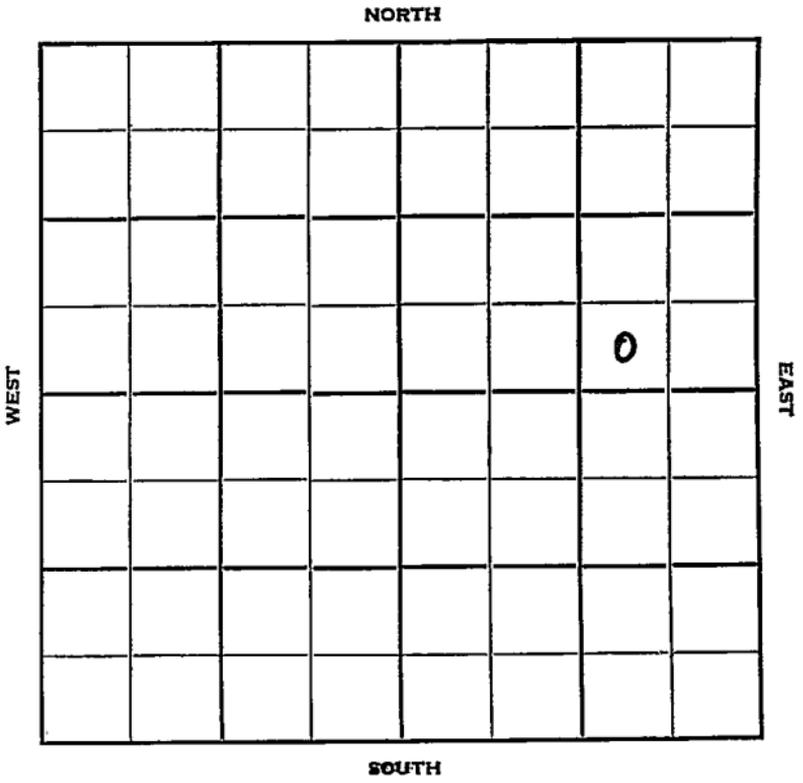

Sec. 15 Twp. 22 R. 13W

Well No. #1 Soeken (B) Farm

Petroleum Inc. Company

Garvie Contractor


Ft. from N. Line

330 Ft. from S. Line

990 Ft. from E. Line

Ft. from W. Line

SW SE NE

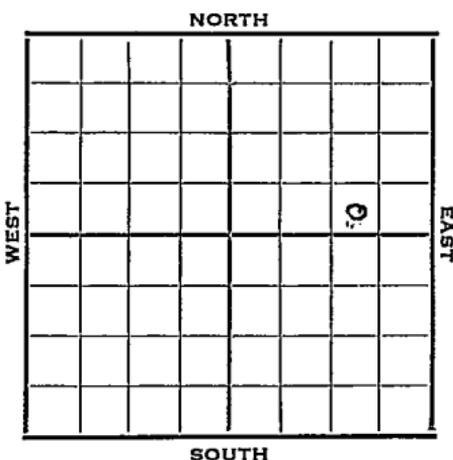

1952 Elev. 1894' REPORT

8/20 Spud 8-18-52  
8" @ 290' WOC

8/27 Anhy 740 Heeb. 3247  
Br Li 3378 Lans. 3398  
DST 3420-70, 3/4 hr. 15' m 0#  
DST 3512-43, 1/2 hr. 10' m  
Drlg. 3552'

9/3 DST 3345-90 3/4 hr. 20' M 400#  
Cong 3669 Simp 3723  
Arb. 3786  
DST 3787-90 1 hr. 350' gas 430'  
gassy oil 460# RTD 3790 5" @ 3787

9/10 GO 3790 1000 A S/4 BOPH & 10% wtr.  
DD 3794 1250 A S/4 Bfph 36% wtr.

9/17 S/3 Boph & littae wtr.

9/24 NR

10/1 Spud 8-18-52  
Oil Well TD 3794' 8" @ 290'  
Anhy 740 Heeb. 3247  
Br Li 3378 Lans. 3398  
DST 3420-70 open 3/4 hr. rec. 15'  
mud 0#  
DST 3512-43 open 1/2 hr. rec. 10' mud  
0#  
DST 3545-90 open 3/4 hr. rec. 20'  
mud 400 #

OVER

1952

10/1

Cong. 3669

Simp. 3723

Arb. 3786

DST 3787-90 open 1 hr. rec. 350' gas

430' gassy oil 460# TD 3790'

5" @ 3787 CO to 3790 1000 A

S/ 4 boph 10% wtr. DD 3794

1250A S/ 4 bfph 36% wtr. S/ 3 boph

Comp. 72 bopd

**COMPLETED**

County Stafford State Kansas

Sec. 15 (Blk. Twp.) 22 (Sur. Rge.) 13W Map No.

Operator Petroleum Inc.

Well No. 1 Farm Saeken (B)

Elev. \_\_\_\_\_ Location SW SE NE


FIRST REPORT

330 Ft. From S Line NE

990 Ft. From E Line Quarter

1st. Report AUG 20 1952

Completion \_\_\_\_\_

Remarks \_\_\_\_\_

Garvie - Contr.

Spudding Date 8-18-52

Drlg. Data \_\_\_\_\_

8" @ 290 WOC

J. G. MCGEHEE

