


Section 15 Township 22 Range 13W

Well No. 3 Moon

Company Franco Central

Kenilworth Pool

NORTH

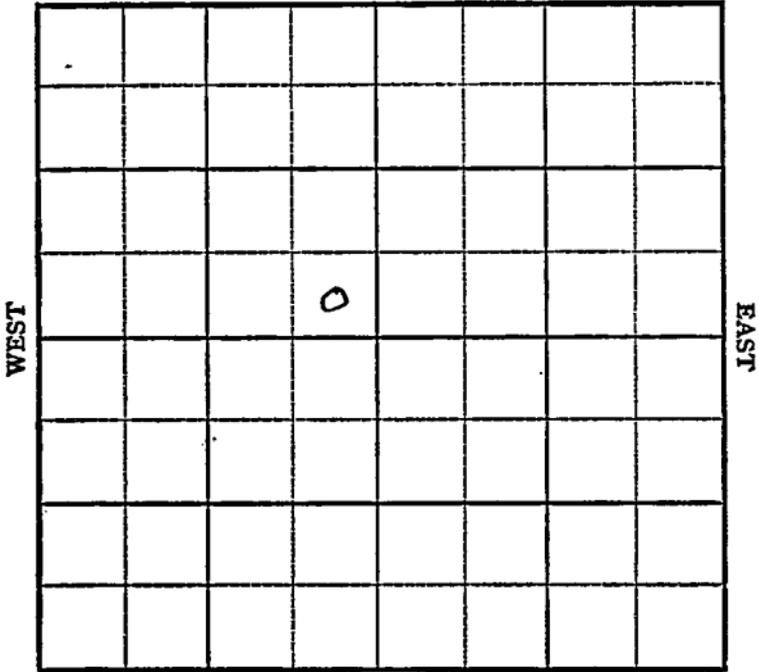

SOUTH

Sec. 15 Twp. 22 R. 13-W

Well No. #3 Moon Farm

Franco Central Company


Kenilworth

_____ Ft. from N. Line

330 Ft. from S. Line

330 Ft. from E. Line

_____ Ft. from W. Line

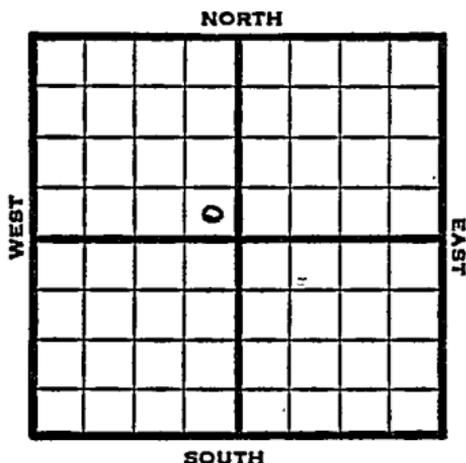

SE NW

1948 Eli 1893' REPORT

10/6 Location

10/13 10" @ 304'
Drlg. 3317'

10/19 Arbuckle 3791'
TD 3793'
5" @ 3791'

10/26 TD 3806'
1000 acid swb 10 bbls - PH 4 hrs.

11/3 Plug 3600
30 shots 3512-20 1000 acid
Swb 30 bbls oil PH

11/10 "

11/16 "

11/23 "

12/1 TD 3806'
Arb. 3789'
5"@ 3791'
2000 acid
Pump 488 Oil Pot
36° Gr.
Comp

COMPLETED

Map No. _____ Sec. 15 Twp. 22 R. 13W

Well No. 3 Moon

Franco Central Company

FIRST REPORT Contractor

SE NW

SECTION PLAT

_____ Ft. from N. Line

330 Ft. from S. Line

330 Ft. from E. Line

_____ Ft. from W. Line

Stafford County

Location X

Rig up _____

Drilling and Remarks:

RECORD

Cased _____ in., _____ ft.

Sand _____

Gas _____

Oil _____

Total Depth _____

PRODUCTION

1st 24 hrs. Nat. _____

1st 24 hrs. after shot _____

Gas _____ Cu. Ft.

Dry Hole _____

Abandoned _____

Date

OCT 6 1948

S. J. LEWIS Scout

