

Section 15 Township 22 Range 13W

Well No. #3 Ochel

Company Phillips
Kenilworth Pool

NORTH

WEST		0					EAST

SOUTH

KANSAS Stafford

Sec. 15 Twp. 22 R. 13W

Well No. #3 Ochel Farm

Phillips Company


Kenilworth

330 Ft. from N. Line

_____ Ft. from S. Line

_____ Ft. from E. Line

990 Ft. from W. Line

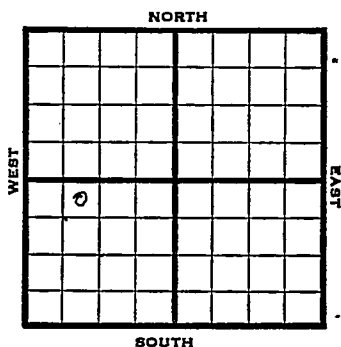

NE NW SW

1948

Elev. 1894' REPORT

4/14

Location

4/21

8" @ 452'
WOC

4/28

Drlg. 3205'

5/5

Lansing 3411'
Viola 3721'
Simpson 3771'
Arbuckle 3823'
TD 3851'
Run csg.

5/12

5" @ 3853'

5/19

5" @ 3823' corrected
Drlg. 3854'

6/1

Arbuckle 3823'
5" @ 3823'
TD 3854'

ABANDONED

Map No. _____ Sec. 15 Twp. 22 R. 13W

Well No. 3 Ochel

Phillips Company

FIRST REPORT

Contractor _____

NE NW SW

SECTION PLAT

330 Ft. from N. Line

_____ Ft. from S. Line

_____ Ft. from E. Line

990 Ft. from W. Line

	o		

Stafford County

Location X

Rig up _____

Drilling and Remarks:

RECORD

Cased _____ in., _____ ft.

Sand _____

Gas _____

Oil _____

Total Depth _____

PRODUCTION

1st 24 hrs. Nat. _____

1st 24 hrs. after shot _____

Gas _____ Cu. Ft.

Dry Hole _____

Abandoned _____

Date

APR 14 1948 19

S. J. LEWIS Scout

Map No. 82 Sec. 15 Twp. 22 R. 13W

Well No. 3 Ochel

Phillips Company

ABANDONED

Contractor

NE NW SW

E. 1894
SECTION PLAT

330 Ft. from N. Line

_____ Ft. from S. Line

_____ Ft. from E. Line

990 Ft. from W. Line

o			

Stafford County

Location _____

Rig up _____

Drilling and Remarks:

CR 83823

5" CR 83823

RECORD

Cased _____ in., _____ ft.

Sand _____

Gas _____

Oil _____

Total Depth 9854

PRODUCTION

1st 24 hrs. Nat. _____

1st 24 hrs. after shot _____

Gas _____ Cu. Ft.

Dry Hole _____

Abandoned _____

Date

JUN 1 1948

19

S. J. LEWIS Scout