


KANSAS

Stafford

Section 15 Township 22 Range 13WWell No. 1 SoekenCompany Great Lakes CarbonKenilworth

NORTH

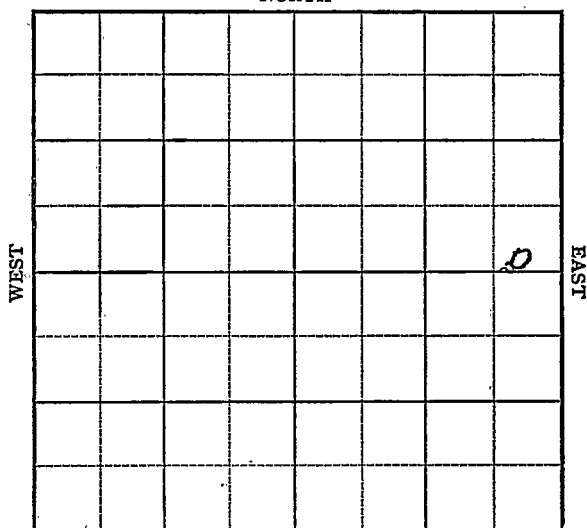

SOUTH

KANSAS

Stafford

Sec. 15 Twp. 22 R. 13W ✓

Well No. #1 Soeken Farm

Great Lakes Company


Kenilworth

 Ft. from N. Line

330' Ft. from S. Line

330' Ft. from E. Line

 Ft. from W. Line

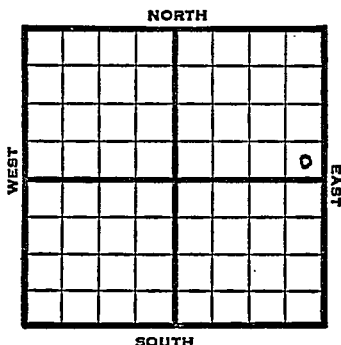

SE NE

1949

Elev. 1891' REPORT

3/30

8" @ 322'
Drlg. 2230'

4/6

Lansing 3408'
Drlg. 3540'

4/13

TD 3872'
Viola 3698'
Arb 3879' 3819'
Aband.

ABANDONED

Map No. _____ Sec. 15 Twp. 22 R. 13W

Well No. 1 Soeken

Great Lakes Carbon Company

FIRST REPORT

Contractor

SE NE


SECTION PLAT

_____ Ft. from N. Line

330 Ft. from S. Line

330 Ft. from E. Line

_____ Ft. from W. Line

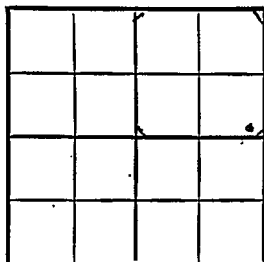

Stafford County

Location _____

Rig up _____

Drilling and Remarks:

8" @ 322

drlg. 2230

RECORD

Cased _____ in., _____ ft.

Sand _____

Gas _____

Oil _____

Total Depth _____

PRODUCTION

1st 24 hrs. Nat. _____

1st 24 hrs. after shot _____

Gas _____ Cu. Ft.

Dry Hole _____

Abandoned _____

Date .

MAR 30 1949 19

S. J. LEWIS

Scout

Kansas

Map No. 82 Sec. 15 Twp. 22 R. 13WWell No. 1 SoekenGreat Lakes Carbon

Company

ABANDONED

Contractor

SE NE

E. 11891
SECTION PLAT

			0

 Ft. from N. Line330 Ft. from S. Line330 Ft. from E. Line Ft. from W. Line

Stafford County

Location Rig up

Drilling and Remarks:

*W 2698**Per 43879***RECORD**Cased in. ft.Sand Gas Oil Total Depth 3872**PRODUCTION**1st 24 hrs. Nat. 1st 24 hrs. after shot Gas Cu. Ft.Dry Hole Abandoned

Date

APR 13 1949 19S. J. LEWIS

Scout