

KANSAS

Stafford


Section 15 Township 22 Range 13W

Well No. 1 Howard "B"

Company Franco Central

Kenilworth

NORTH

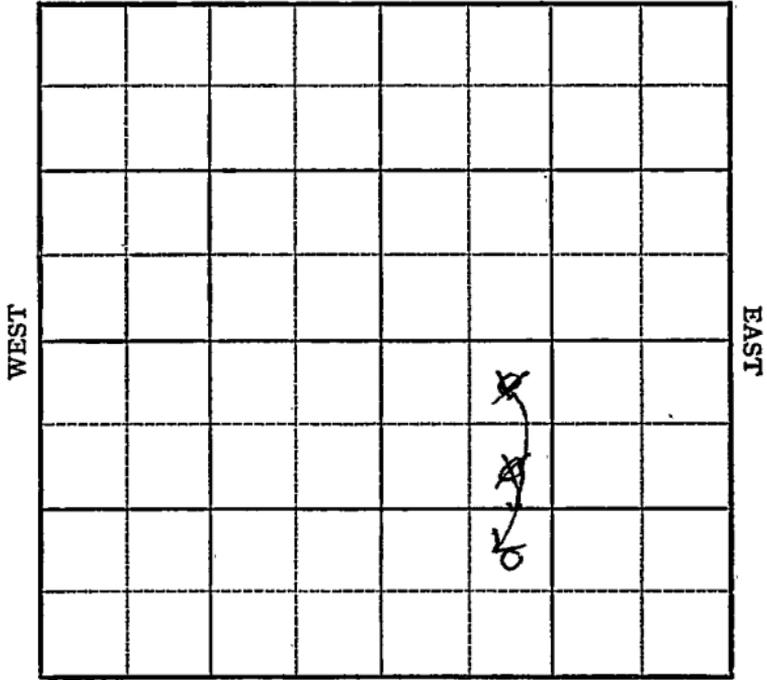

SOUTH

KANSAS

Stafford

Sec. 15 Twp. 22 R. 13W ✓

Well No. #1 Howard "B" Farm

Franco Central Company


Kenilworth Pool

_____ Ft. from N. Line

990' Ft. from S. Line

_____ Ft. from E. Line

990' Ft. from W. Line

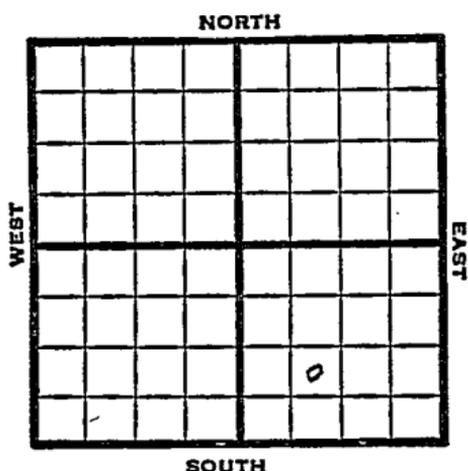

NE SW SE

1949 Elev 1894' REPORT

3/23 RUR
 3/30 8" @ 290'
 Drlg. 2275'
 4/6 Lansing 3288'
 Viola 3688'
 Simpson 3731'
 Arbuckle 3788'
 TD 3791'
 5" @ 3790'
 4/12 "
 4/20 TD 3793'
 1000 acid
 Pump 15 bbls oil PH - 10 hrs.
 4/27 "
 5/4 TD 3793'
 Arb. 3788'
 5" @ 3790'
 1000 acid
 Pump 652 Oil Pot
 39° Gr.
 Comp

COMPLETED

Map No. _____ Sec. 15 Twp. 22 R. 13W

Well No. 1 Howard "B"

Franco Central Company

FIRST REPORT

Contractor

NE SW SE


SECTION PLAT

_____ Ft. from N. Line

990 Ft. from S. Line

_____ Ft. from E. Line

990 Ft. from W. Line

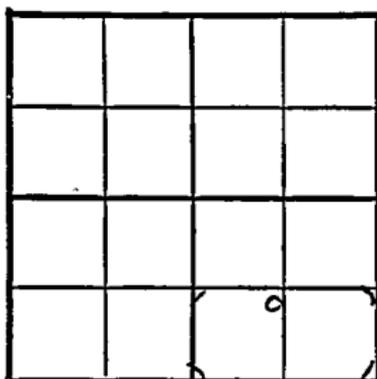

Stafford County

Location _____

Rig up _____

Drilling and Remarks:

R U R

RECORD

Cased _____ in., _____ ft.

Sand _____

Gas _____

Oil _____

Total Depth _____

PRODUCTION

1st 24 hrs. Nat. _____

1st 24 hrs. after shot _____

Gas _____ Cu. Ft.

Dry Hole _____

Abandoned _____

Date

MAR 23 1949 19

S. J. LEWIS Scout

Kansas

Map No. K82 Sec. 15 Twp. 22 R. 13W

Well No. 1 Howard "B"

Franco Central Company

COMPLETE

Contractor

NE SW SE

E. 1894
SECTION PLAT

_____ Ft. from N. Line

990

_____ Ft. from S. Line

_____ Ft. from E. Line

990

_____ Ft. from W. Line

Stafford County

Location _____

Rig up _____

Drilling and Remarks:

Cur 3788
5' @ 3790
1000 acid
Run 652 oil test
39' @

RECORD

Cased _____ in., _____ ft.

Sand _____

Gas _____

Oil _____

Total Depth 3788

PRODUCTION

1st 24 hrs. Nat. _____

1st 24 hrs. after shot _____

Gas _____ Cu. Ft.

Dry Hole _____

Abandoned _____

Date

MAY 4 1949

19

S. J. LEWIS

Scout