

Section 15 Township 22 Range 14WWell No. 2 GoreCompany Stearns

							0

NORTH

WEST

EAST

SOUTH

Stafford KANSAS

SEC.	TWP.	R.
15	22	14W ✓
WELL NO.		
2 Gore		FARM
COMPANY		
Stearns Drlg.		
CONTRACTOR		


Wildcat

330 Ft. from N. Line

Ft. from S. Line

330 Ft. from E. Line

Ft. from W. Line

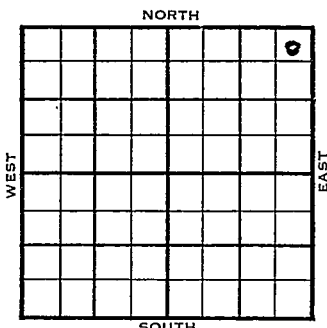

NE NE NE

Sunray Farmout - Atlantic - DHM

	ELEVATION	REPORT
1954	1935'	
2/3	MIR	
2/10	8" @ 247' w/150 sks	
	Anhy 824'	
	Drlg 2900'	
2/17	Spud 2-3-54	
	D&A	
	TD 3815'	
	8" @ 247'	
	Anhy 824', Heeb 3296', Tor 3317',	
	Doug. 3332', Br lime 3421', Lans	
	3435'	
	DST 3493-3524', opn 1 hr., rec. 10'	
	soem, 23' wcm, 310#	
	DST 3551-81', opn 1 hr., rec. 1065'	
	sw, 1270#	
	DST 3607-25', opn 1 hr., rec. 10' mud,	
	80#	
	B KC 3670', Cong 3702', Viola 3720',	
	Simp. 3747, Arb. 3803	
	DST 3799-3815', opn 1 hr., rec. 1230'	
	sw, 1140#	
	TD 3815'	
	D&A	

ABANDONED

Sec. **15** (Blk. **22** (Sur. **14W** Map No.

Well No. **2** Farm **Gore**

Elev.	Location	NE NE NE

0

FIRST REPORT

330 Ft. From T₁ Line Quarter

1st. Report FEB 3 1954

Completion

Remarks	Sunray Farmout Atlantic - 1976
---------	-----------------------------------

Spudding Date

Drig. Data **Wildcat**

U I R

J. G. McGEHEE

J. G. McGEHEE