


Section 15 " Township 22 Range 11W

Well No. #3 Smith "N"

Company Cities Service.

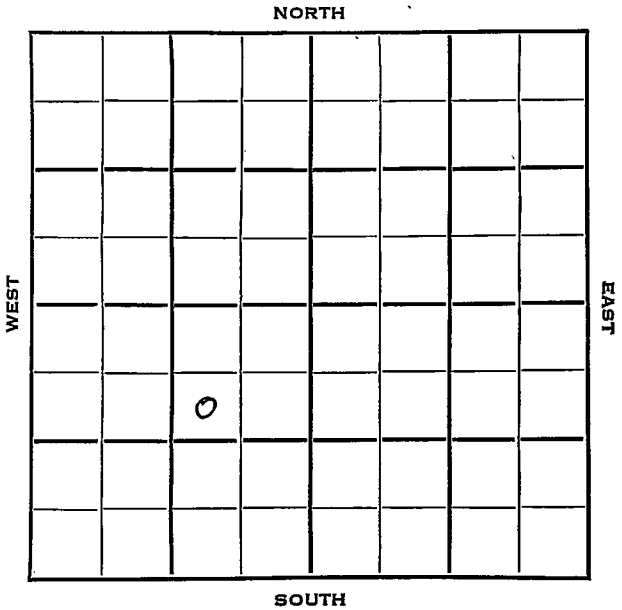

Sec. _____ Twp. _____ R. _____

#3 Smith "N"

Well No. _____ Farm _____

Cities Service

Company _____

HolmDrlg.

W. Osear Pool

Contractor _____


990 Ft. from N. Line

_____ Ft. from S. Line

990 Ft. from E. Line

_____ Ft. from W. Line

SW NE SW

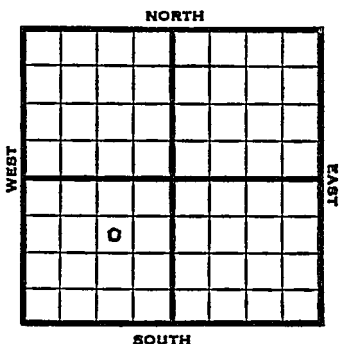

1953

Elev. 1944' REPORT

4/22

Location

4/30

8" @ 402'

5/7

Heeb 3327, Br li 3456, Lans 3470
Drlg. 3581

5/13

Spud 4-27-53 D & A TD 3710'
8" @ 402 Heeb 3327 Br lime 3456
Lans 3470

DST 3585-96 open 1 hr rec 14' mud O#

DST 3595-3640 open 1 hr rec 17' mud

150# B KC 3703 TD 3710'

D & A

ABANDONED

