


Section 15 Township 22 Range 14 W

Well No. # 4 Smith "N"

Company Cities Service Oil

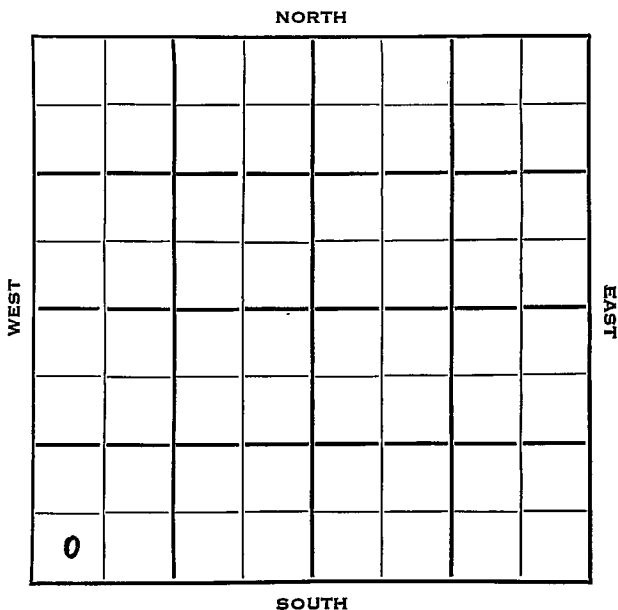

Sec. 15 Twp. 22 R. 11W

Well No. #4 Smith "N" Farm

Cities Service Oil Company

Holm Drlg. Contractor

W. Oscar Pool


\_\_\_\_\_ Ft. from N. Line

330 Ft. from S. Line

\_\_\_\_\_ Ft. from E. Line

330 Ft. from W. Line

SW SW SW

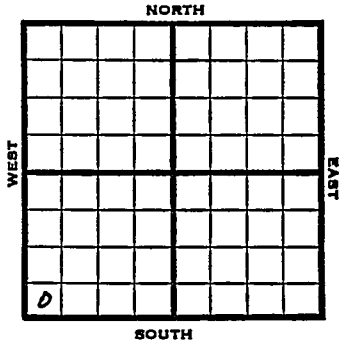

1953 Elev. 1943' REPORT

- 7/1 Loc.
- 7/8 "
- 7/22 "
- 7/29 8" @ 413 Heeb 3336 Dodge 3358  
Br Lime 3463 Lans 3473  
DST 3594-3613, 1 hr, 1500' GCO,  
300' SM & GCO 855#  
RTD 3630' 5" @ 3630
- 8/5 CO 3614 52/3593-3606 9 BOPH 12 hrs.  
2000 A P/274 BO 16½ hrs.
- 8/12 Spud 7-14-53  
Oil Well  
TD 3630'  
8" @ 413'  
Heeb 3336, Dodge 3358, Br. Lime 3463,  
Lans 3473  
DST 3594-3613 opn 1 hr, rec 1500'  
gco, 300' sm & gco 855#  
TD 3630'  
5" @ 3630'  
CO to 3614'  
52/ 3593-3606 9 boph 12hr. 2000 A  
P/ 274 bo 16½ hr.  
Comp. BHB 2677 bopd.

COMP. TEST



County Stafford State KansasSec. 15 (Blk. 22 (Sur. 14W (Twp.) 22 (Rge.) 14W Map No.Operator Cities Service OilWell No. 4 Farm Smith "N"Elev. 1943 Location SW SW SW

0					

330 Ft. From S Line SW330 Ft. From W Line Quarter

1st. Report \_\_\_\_\_

Completion AUG 12 1953Remarks W. Oscar PoolHolm Drlg. - Contr.Spudding Date 7-14-53Drlg. Data Oil well TD 36308" @ 413 Heeb. 3336 Dodge 3358Br. lime 3463 Lans. 3473 DST 3594-3613open 1 hr. Rec. 1500' gco 300' sm & gco855# TD 3630 5" @ 3630 CO to 361452/ 3593-3606 9 boph 12 hr. 2000 AP/ 274 bo & 16 $\frac{1}{2}$  hr. Comp. BHB 2677 bopd