


Section 15 Township 22 Range 11W

Well No. #1 Schmidt "L"

Company Cities Service

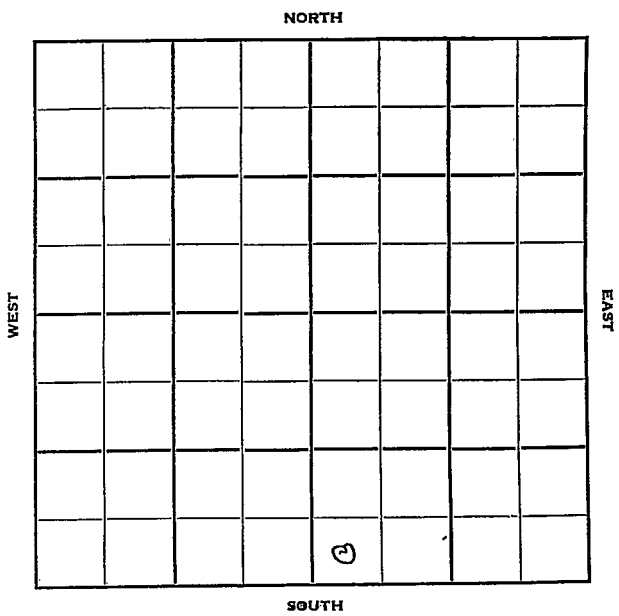

Stafford

KANSAS

14W

Sec. 15 Twp. 22 R. 14W

Well No. #1 Schmidt "L" Farm

Cities Service Company

Holm Drlg. -Contr. Contractor


 Ft. from N. Line

330' Ft. from S. Line

 Ft. from E. Line

330' Ft. from W. Line

SW SW SE

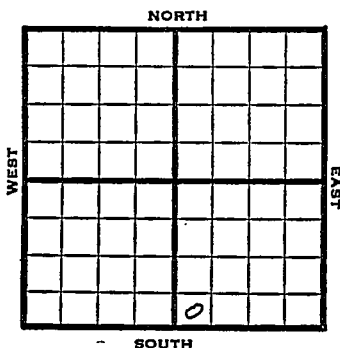

1952 Elev. 1932' REPORT

5/14 Location

5/20 8" @ 407'

Drlg. 1930'

5/28 Heeb. 3320 Br Li 3446

Lans. 3458

DST 5476-99 1 hr. 12' M

DST 3599-3624 1 hr. 30' SGCM

Drlg. 3690'

6/4 Spud 5-17-52 D&A TD 3870

8" @ 407' Heeb. 3320 Br Li 3446

Lans. 3458

DST 3576-99 open 1 hr. rec. 30' sgcm

Cong. 3737 Viola 3740

DST 3742-70 open 1 hr. rec. 10' mud

Simp. 3784

Arb. 3844

TD 3870 D&A

ABANDONED



Sec. **15** (Blk. **22** (Sur. **14W** Map No.

Well No. 1 Farm Schmidt "L"

Elev.	Location	SW	SW	SE
-------	----------	----	----	----

FIRST REPORT

330 Ft. From **S** Line **SE**

330 Ft. From ~~IV~~ Line Quarter

1st. Report MAY 14 1952

Completion

Remarks

Holm Drlg. - Contr.


Spudding Date _____

Drlg. Data

Location

J. G. McGEHEE

County Stafford State Kansas
 Sec. 15 (Blk. Twp.) 22 (Sur. Rge.) 14W Map No.
 Operator Cities Service
 Well No. 1 Farm Schmidt "L"
 Elev. 1932 Location SW SW SE

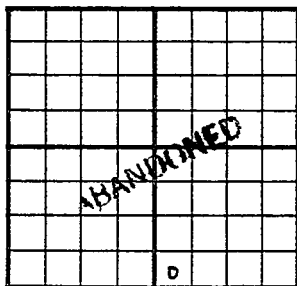

330 Ft. From S Line SE
330 Ft. From W Line Quarter
 1st. Report
 Completion JUN 4 1952
 Remarks

Holm Drlg. - Contr.

Spudding Date 5-17-52

Drlg. Data D & A TD 3870

8" @ 407 Heeb. 3320 Br. lime 3446

Lans. 3458 DST 3576-99 open 1 hr.

Rec. 12' mud DST 3599-3624 open 1 hr.

Rec. 30' sgcm Cong. 3737 Viola 3740

DST 3742-70 open 1 hr. Rec. 10' mud

Simp. 3784 Arb. 3844 TD 3870

D & A

J. G. McGEHEE