


Section 15 Township 22 Range 11W

Well No. #1 Smith (N)

Company Cities Service Oil

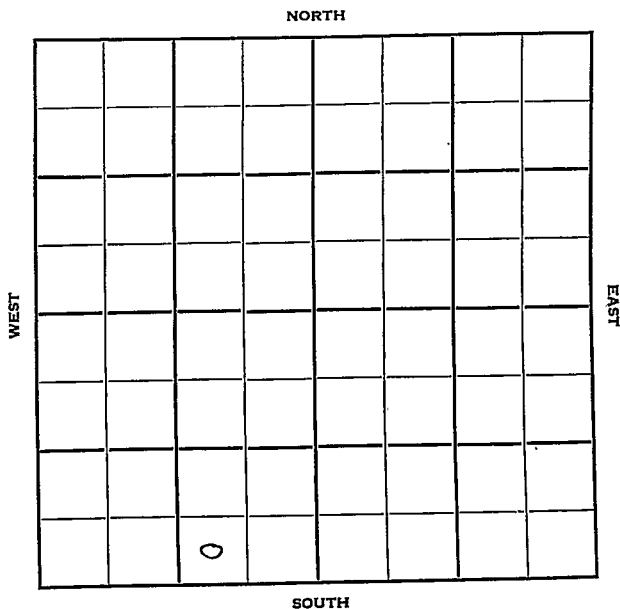

Sec. 15 Twp. 22 R. 14 W

Well No. # 1 Smith (N) Farm

Cities Service Oil Company

Contractor


_____ Ft. from N. Line

330 Ft. from S. Line

990 Ft. from E. Line

_____ Ft. from W. Line

SW SE SW

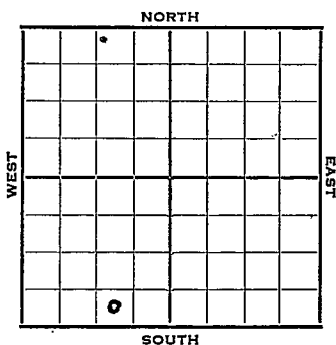

1952

Elev. 1947' REPORT

9/17 Cellar & Pits
 9/24 8" @ 404 Drlg. 2060'
 10/1 Br Li 3457 Lans. 3469
 DST 3585-97, 1 hr. 60' O&GCM
 180' GCO
 DST 3599-3618, 1 hr. 30'm 5' SO CM
 DST 3624-37, 1 hr. 50' SW 1070#
 BKC 3704 RTD 3715'
 10/8 5" @ 3715' CO to 3698'
 10/15 48/3585-3601 2000A
 F 152 BO 12 hrs., WOP
 10/22 No report
 10/29 NR
 11/5 "
 11/12 "
 11/19 Spud 9-19-52
 Oil Well
 TD 3715'
 8" @ 404
 Br. lime 3457, Lans. 3469',
 DST 3585-97, opn 1 hr., rec.
 60' o & gem, 180' gco
 DST 3599-3618, opn 1 hr., rec.
 30' mud, 5' socm, 0#
 DST 3624-37, opn 1 hr., rec.
 50' sw 1070#

OVER

(Information Brought Forward)

1952

11/19

B KC 3704,

TD 3715,

5" @ 3715,

CO to 3698, 49/3585-3601,

2000A F/152 bo 12 hrs.,

Comp. 1214 boph

COMPLETED

