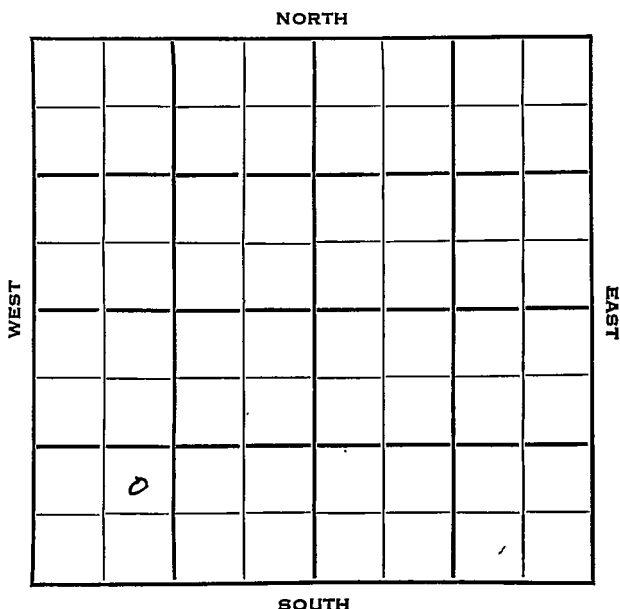


Section 15 Township 22 Range 11WWell No. #2 Smith "N"Company Cities Service Oil Company

Stafford

KANSAS ✓

15

22

14W

Sec. _____ Twp. _____ R. _____

Well No. #2 Smith "N" Farm _____

Cities Service

Company _____

Holm Drlg. - Contr.

Contractor _____

W. Oscar Pool

Ft. from N. Line

990


Ft. from S. Line

Ft. from E. Line

990

Ft. from W. Line

NE SW SW

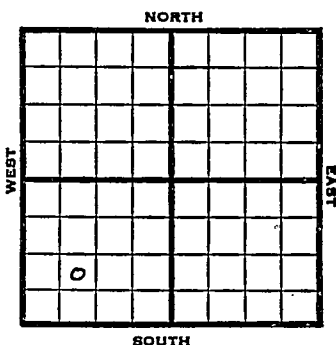

1953

Elev. 1944'

REPORT

3/11

Location

3/19

"

3/26

8" @ 405 Br li 3456
 Lans 3468'
 Drlg. 3491

4/2

DST 3584-97 1 Hr. 1830' oil
 160' muddy oil 810# 20"
 RTD 3640
 5" @ 3640

4/9

CO 3625 77/3581-3601
 1225' oil 1 Hr.
 P/179 BO 15 hrs. 3000A,
 P/234 BO + 6 BW 17 hrs.


4/15

Spud 3-16-53
 Oil Well
 TD 3640
 8" @ 405
 Br. Lime 3456, Lans 3468
 DST 3584-97 open 1 hr, Rec 1830' oil
 160' muddy oil, 810#
 TD 3640'
 5" @ 3640
 CO to 3625
 77/ 3581-3601 FU 1225' oil 1 hr.
 P/ 179 bo 15 hr. 3000A P/ 234 bo
 6 bw 17 hr.
 Comp. 1611 bopd.

COMPLETED

J. G. McGEHEE

County Stafford State Kansas
 Sec. 15 (Blk. 22) (Sur. 14W) Map No.
 Operator Cities Service
 Well No. 2 Farm Smith "N"
 Elev. 1944 Location NE SW SW

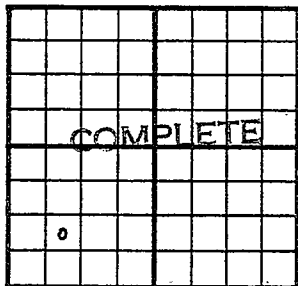

990 Ft. From S Line SW
990 Ft. From W Line Quarter
 Ist. Report
 Completion APR 15 1953
 Remarks W. Oscar Pool
Holm Drlg. - Contr.
 Spudding Date 3-16-53

Drlg. Data Oil well TD 3640
8" @ 405 Br. line 3456 Lans. 3468
DST 3584-97 open 1 hr. Rec. 1830' oil
160' muddy oil 810# TD 3640 5" @ 3640
CO to 3625 77/ 3581-3601 FU 1225' oil
1 hr. P/ 179 bo 15 hr. 3000 A
P/ 234 bo 6 bw 17 hr.
Comp. 1611 bopd

J. G. McGEHEE