


Section 15 Township 22 Range 3-W

Well No. #1 Neufeldt

Company Falcon-Seaboard etal

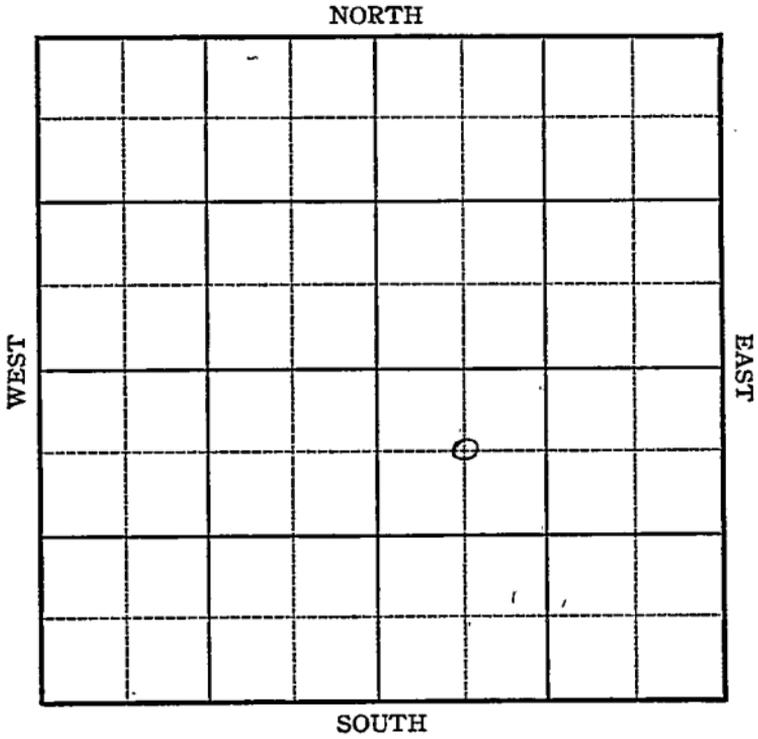

Sec. 15 Twp. 22 R. 3-W

Well No. #1 Neufeldt Farm

Falcon-Seaboard etal. Company

Wildcat


660 Ft. from N. Line

_____ Ft. from S. Line

_____ Ft. from E. Line

660 Ft. from W. Line

Eleo. 1434

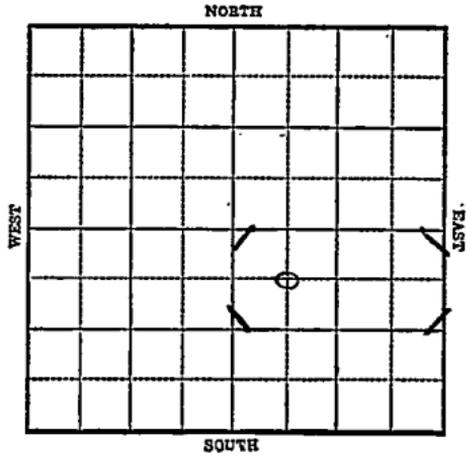

1943

R E P O R T

- 4/7 Derrick
- 4/14 "
- 4/21 Rotary
- 4/28 8" @ 173'
Drlg. 2220'
- 5/5 Topeka 1880
Lans 2483
Drlg. 2650'
- 5/12 Miss 3232
Drlg. 3415
No show
- 5/19 Hunton 3573
Viola 3695
Simp. 3721
Arb. 3800
T.D. 3820

ABANDONED

Harvey


KANSAS

Map No. 43 Sec. 15 Twp. 22 R. 3WWell No. 1 NeufeldtFalcon-Seaboard etal. Company**FIRST REPORT**

Contractor

C NW SE

SECTION PLAT

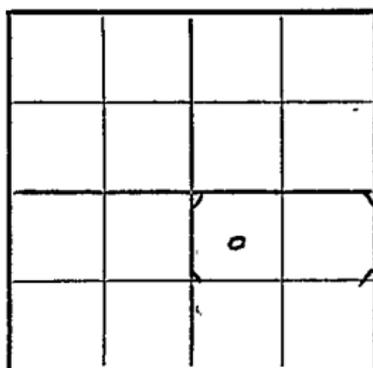660 Ft. from N. Line Ft. from S. Line Ft. from E. Line660 Ft. from W. Line**WILDCAT**Location Rig up

Drilling and Remarks:

Derrick

RECORD

Cased in. ft.Sand Gas Oil Total Depth

PRODUCTION

1st 24 hrs. Nat. 1st 24 hrs. after shot Gas Cu. Ft.Dry Hole Abandoned

Date

APR 7 1943 19S. J. LEWIS

Scout

KANSAS

Map No. 43 Sec. 15 Twp. 22 R. 3W

Well No. 1 Neufeldt

Falcon-Seaboard etal. Company

ABANDONED Contractor

C NW SE

SECTION PLAT

660 Ft. from N. Line

_____ Ft. from S. Line

_____ Ft. from E. Line

660 Ft. from W. Line

		o	

WILDCAT

Location _____

Rig up _____

Drilling and Remarks:

Hunter 3528
Vedla 3695
Simp 3721
Co 4 3800

RECORD

Cased _____ in., _____ ft.

Sand _____

Gas _____

Oil _____

Total Depth 3820

PRODUCTION

1st 24 hrs. Nat. _____

1st 24 hrs. after shot _____

Gas _____ Cu. Ft.

Dry-Hole _____

Abandoned _____

Date

MAY 1 9 1943 19

S. J. LEWIS Scout