


Hodgman

KANSAS

SECTION 15 TOWNSHIP 22S RANGE 25W

WELL NO. #1 Kline

COMPANY Kewanee Oil

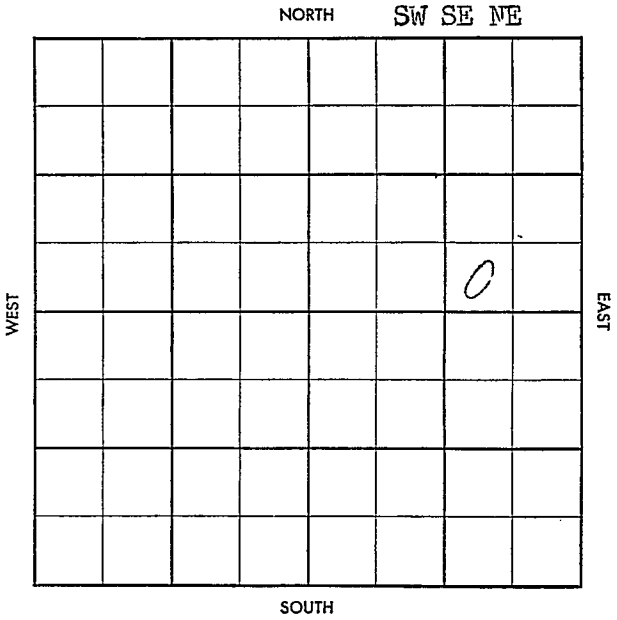

WILDCAT

S-513-A

CO. Hodgman ELEV. _____
SEC. 15 TWP. 22 RGE. 25W
COMPANY Kewanee Oil NO. 1

FIRST REPORT

FARM Kline
LOC. SW SE NE

GEOL. _____
CONTR. Graham-Michaelis
POOL Wildcat
SPUD _____
Location _____

CO.
LSE.
NO.
SEC.
TWP.
RGE.

