


SECTION 15 TOWNSHIP 22 RANGE 32WWELL NO. #1 CornCOMPANY A.D. McKelvy

NORTH C NW

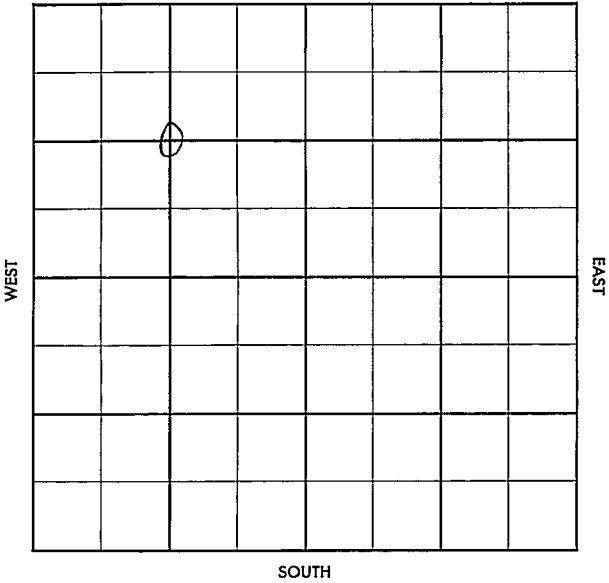

County Finney Elev. _____
Sec. 15 Twp. 22 Rge. 32W
Company A. D. McKelvy
FarmName Corn No. 1

TOPS	DEPTH	LOG	DATUM
Anh.			
Tr.			
H.			
Tr.			
Dg.			
Bl.			
L.			
K.C.			
B.K.C.			
Ce.			
C.			
M.			
M.			
K.			
Mz.			
Mq.			
V.			
S.			
S.			
A.			
R.			
PE.			
G.			
T.D.			

Loc. in Sec. C NW
Geol. _____
Contr. _____
Graham-Mich. T⁵s
Pool _____
Hugoton

FIRST REPORT			

FEB 20 '57

Date Comm. M I R
35

Co.
No.
R.

County Finney Elev. 2932
 Sec. 15 Twp. 22 Rge. 32W
 Company A. D. McKelvy
 Farm Name Corn No. 1

TOPS	DEPTH	LOG	DATUM	Loc. in Sec.
Anh. <u>Herr</u>		<u>2635</u>		<u>G NW</u>
Tp. <u>U KPI</u>		<u>2668</u>		
H. <u>L KPI</u>		<u>2685</u>		
Tr. <u>WPA</u>		<u>2722</u>		
Dg.				
Bl.				
L.				Geol.
K.C.				Contr.
B.K.C.				<u>Graham-Mich. T.S.</u>
Ce.				
C.				
M.				
M.				Pool
K.				<u>Hugoton</u>
Mz.				
Mo.				
V.				
S.				
S.				
A.				
R.				
PE.				
G.				
TD.	<u>2750</u>			

MAR 20 57
 COMPLETE

Date Comm.

MIR - 327^{FF} 2 - 20 - 57 898 415

1250 5 1/2 2749 / 300 MAR 5 32 CO

2741 16 / 2724 - 28 1 92 3 140 MCF

2770 32 / 2690 - 98 32 / 2675 - 78

92. 10 1/2 MIII CFC MAR 13 57 MAR. 20 57

FRAC 8 X 8 CO 2740

92 9.762 MCFG 72 - 20 92 20.100

MCFG PD. RP 428#