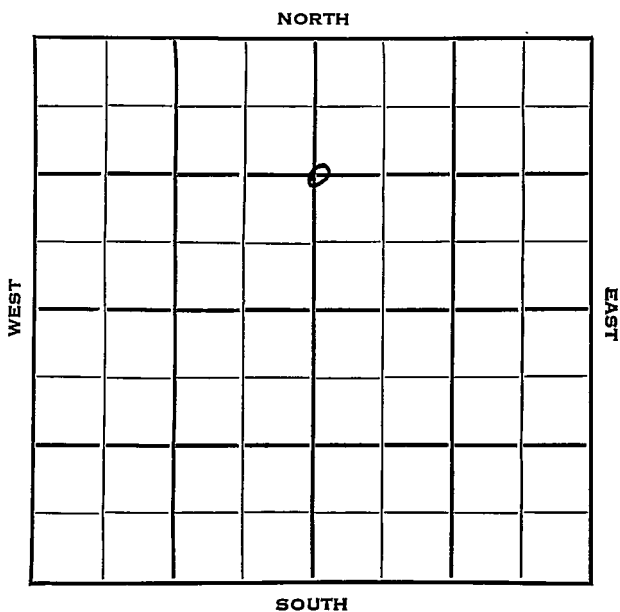


Section 15 Township 22 Range 34WWell No. 1 CookCompany Kansas-Nebraska

Finney

KANSAS

SEC.	TWP.	R.
15	22	34W ✓

WELL NO.

#1 Cook

FARM

COMPANY

Kansas-Nebraska

CONTRACTOR

1320

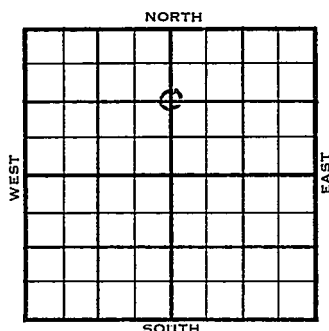
Ft. from N. Line

Ft. from S. Line

2540

Ft. from E. Line

Ft. from W. Line

C N $\frac{1}{2}$ Sec.

1954

ELEVATION

2940'

REPORT

1/27

8" @ 240'

Herr. 2544', Kr. 2564', Win 2600',
 TD 2650'
 5" @ 2643'

2/3

C.O. 2643'

16/2550-78 132/ 2600-2622 300 A
 frac. 4000 A

2/17

Gas well TD 26508 8" @ 240

er. 2544' Kri. 2564' Win. 2600

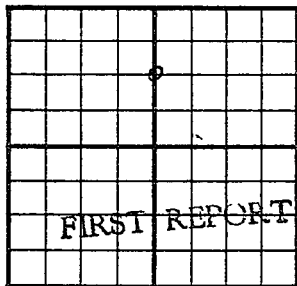
TD 2650 5" @ 2643 CO to 2643

168/2550-78 132/2600-22 300 A

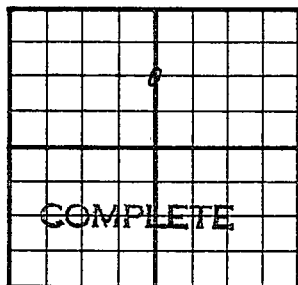
frac. 4000 A

Comp. 3,785,000 gas.

COMPLETED

County Finney State KansasSec. 15 (Blk. 22 (Sur. 34W Map No.)
(Twp.) (Rge.)Operator Kansas-NebraskaWell No. 1 Farm CookElev. Location C N $\frac{1}{2}$ Sec.1320 Ft. From N Line Sec.2540 Ft. From E Line Quarter1st. Report JAN 27 1954Completion Remarks Spudding Date Drig. Data 8" @ 240 Herr. 2544 Kri. 2564Win. 2600 TD 2650 5" @ 2643

J. G. McGEHEE

County Finney State KansasSec. 15 (Blk. Twp.) 22 (Sur. Rge.) 34W Map No.Operator Kansas-NebraskaWell No. 1 Farm CookElev. 2940 Location C n $\frac{1}{2}$ Sec.1320 Ft. From N Line Sec.2540 Ft. From E Line Quarter1st. ReportCompletion FEB 17 1954RemarksSpudding DateDrlg. Data Gas well TD 26508" @ 240 Her. 2544 Kri. 2564Win. 2600 TD 2650 5" @ 2643CO to 2643 168/ 2550-78 132/ 2600-22300 A frac 4000 AComp. 3,785,000 gas

J. G. McGEHEE