


Section 15 Township 22 Range 35W

Well No. #1 Rooney

Company Kansas Nebraska

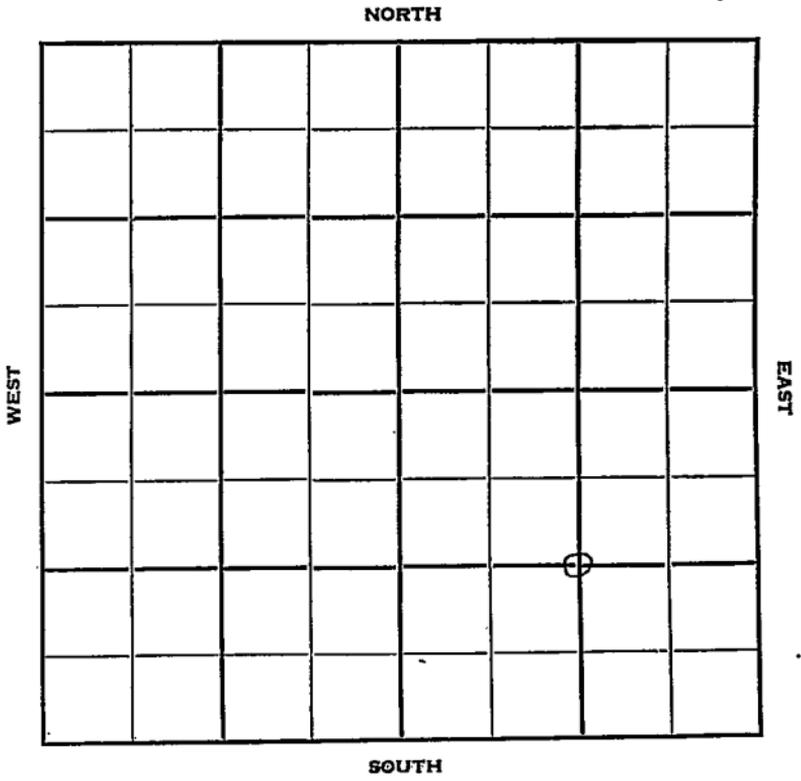

Kearny

KANSAS

Sec. 15 Twp. 22: R. N 35 W

Well No. # 1 Rooney Farm

Kansas-Nebraska Company

Contractor

Hugoton Pool


Ft. from N. Line

1320 Ft. from S. Line

1320 Ft. from E. Line

Ft. from W. Line

G SE/4

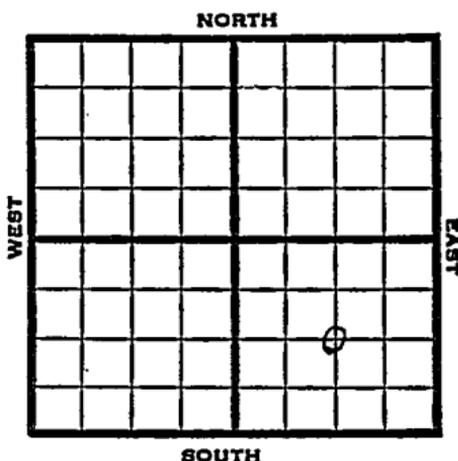

1951

Elev. 3050' REPORT

9/26

Spud 9-22-51
10" @ 312' WOC

12/5

Spud 9-22-51
Gas well TD 2728'
10" @ 312' 7" @ 2542' TD 2728'
Her. 2570' Kri 2600' Win 2622
Ft. Riley 2697'
8000 A
Comp. 4,700,000 gas.

COMPLETED

County Kearny State Kansas

Sec. 15 (Blk. Twp.) 22 (Sur. Rge.) 35W Map No.

Operator Kansas - Nebraska

Well No. 1 Farm Rooney

Elev. 3050 Location C SE/4

COMPLETED

1320 Ft. From S Line SE

1320 Ft. From E Line Quarter

Ist. Report

Completion DEC 5 1951

Remarks Hugoton Pool

Spudding Date 9-22-51

Drilg. Data Gas well TD 2728

10" @ 312 7" @ 2542 TD 2728

Her. 2570 Kri. 2600 Win. 2622

Ft. Riley 2697 8000 A

Comp. 4,700,000 gas