DX 78-1


Stafford

KANSAS

Section 16 Township 22 Range 14 W

Well No. # 2 Boys Home

Company Sunray Oil

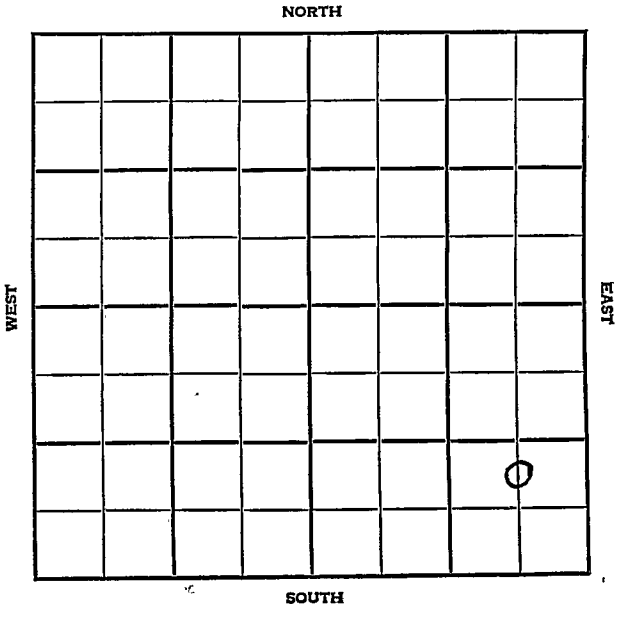

Stafford KANSAS

SEC.	TWP.	R.
16	22	14W

WELL NO.

2 Boys Home FARM

COMPANY

Sunray Oil

CONTRACTOR

Stickle


W. Oscar Pool

_____ Ft. from N. Line

990 Ft. from S. Line

660 Ft. from E. Line

_____ Ft. from W. Line

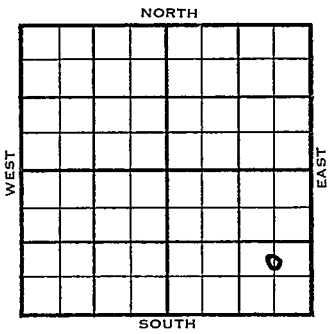

C N/2 SE SE

	ELEVATION	
1955	1946'	REPORT

3/16 Location

4/27 Spud 3-23-55 - Oil Well
TD 3615'
8" @ 375'
Heeb. 3347', Br lime 3474', Lans. 3484
TD 3615'
5" @ 3608'
CO to 3615' 1.4 boph 1750 A
S/24 boph 6 hrs.
P/73 bo 16 hrs.
Comp. 95 bopd

COMPLETED

DX-78

FORM 275 FOR SALE BY KANSAS BLUE PRINT CO.


County Stafford State Kansas

Sec. 16 (Blk. Twp.) 22 (Sur. Rge.) 14W Map No.

Operator Sunray Oil

Well No. 2 Farm Boys Home

Elev. Location C N½ SE SE

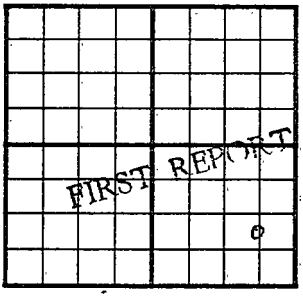

990 Ft. From S Line SE

660 Ft. From E Line Quarter

1st. Report MAR 16 1955

Completion

Remarks

Stickle - Contr.

Spudding Date

Drlg. Data W. Oscar Pool

Location

FABEN GILSTRAP

FORM 275 FOR SALE BY KANSAS BLUE PRINT CO.


County Stafford State Kansas

Sec. 16 (Blk. Twp.) 22 (Sur. Rge.) 14W Map No.

Operator Sunray Oil

Well No. 2 Farm Boys Home

Elev. 1946 Location C N½ SE SE

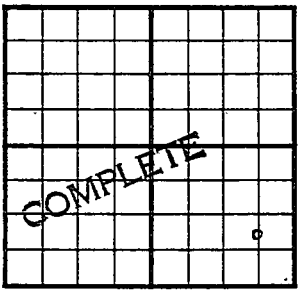

990 Ft. From S Line SE

660 Ft. From E Line Quarter

1st. Report

Completion APR 27 1955

Remarks W. Oscar Pool
Stickle - Contr.

Spudding Date 3-23-55

Drlg. Data Oil well TD 3615

8" @ 375 Heeb. 3347 Br. lime 3474

Lans. 3484 TD 3615 5" @ 3608

CO to 3615 1.4 boph 1750 A

S/ 24 boph 6 hr. P/ 73 bo 16 hr.

Comp. 95 bopd

FABEN GILSTRAP