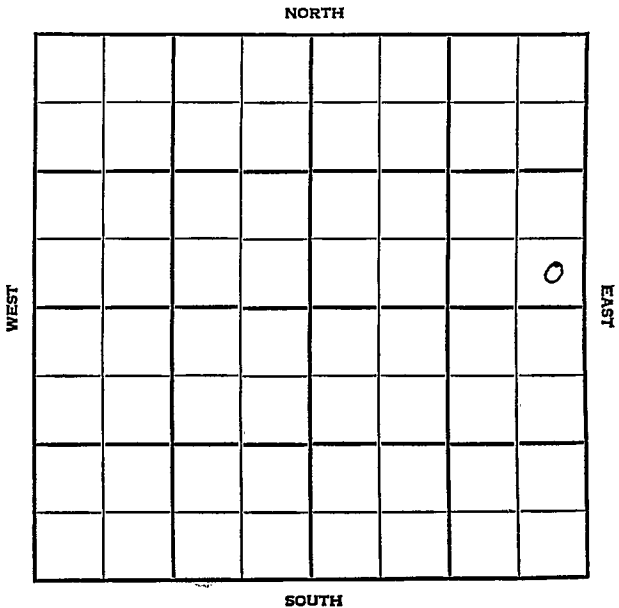


Section 16 Township 22 Range 11 WWell No. #1 DralleCompany Harms & Burt & C.C.Pet.

Stafford

KANSAS

SEC. 16	TWP. 22	R. 14W
------------	------------	-----------

WELL NO.

#1 Dralle

FARM

COMPANY

Harms & Burt & C. C. Pet.

CONTRACTOR

Co. Tools

W. Oscar


_____ Ft. from N. Line

_____ Ft. from S. Line

_____ Ft. from E. Line

_____ Ft. from W. Line

SE SE NE

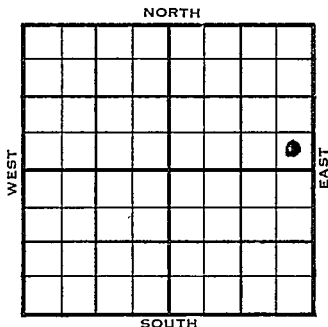

1955%

ELEVATION

1942 DF

1946 KB

REPORT

8/3

Comm. 7-29-55

FIRST REPORT

8" @210/200 Drlg. 2000

8/10

Comm 7-29-55

H 3336

Dg 3376

Bl 3464

L 3474

C 3771

V 3777

S 3823

A 3869

TD 3910

Comm 7-29-55

8" @ 210/200 DST 3591-3610 open 1/2

hr Rec 6' mud 0# DST 3628-41 open

1/2 hr Rec 10' mud 300# DST 3644-62

open 1 hr Rec 2585' sw 1255/20"

D & A

ABANDONED

County

S. afford

Elev.

Sec.

16

Twp.

22

Rge.

14W

Company

Harms & Burt & C.C. Pet.

Farm Name

Draille

No.

1

TOPS

DEPTH

LOG

DATUM

Loc. in Sec.

Anh.

Tp.

H.

Tr.

Dg.

Bl.

L.

K.C.

B.K.C.

Ce.

C.

M.

M.

K.

Mz.

Mq.

V.

S.

S.

A.

R.

P.C.

G.

T.D.

SE SE NE

Geol.

Contr.

Co. tools

Pool

W. OSCAR

FIRST REPORT

AUG 2 1958

Date Comm.

7-29-55

8" @ 210/200

drlg. 2000

Co.

Loc.

No.

Sec.

T.

R.

1943 DF
1946 KB

County

Stafford

Elev.

Sec.

16

Twp.

22

Rge.

14W

Company

Harms & Burt & C.C. Pet.

Farm Name

Dralle

No.

1

TOPS

DEPTH

LOG

DATUM

Loc. in Sec.

Anh.

SE SE NE

TP.

H.

3336

1390

Tr.

Dg.

3376

1430

BL.

3404

1518

L.

3474

1528

K.C.

Geol.

B.K.C.

Ce.

Contr.

C.

3771

1825

Co. tools

M.

M.

Pool

K.

W. Oscar

Mz.

Mq.

V.

3777

1831

S.

3822

1877

S.

A.

3869

1923

R.

PE.

G.

T.D.

3910

ABANDONED

Date Comm.

7-29-55

AUG 10 1955

8" @ 210/200 DST 3591-3610 open $\frac{1}{2}$ hr.

Rec. 6' mud O# DST 3628-41 open

 $\frac{1}{2}$ hr. Rec. 10' mud 300# DST 3644-62

open 1 hr. Rec. 2585' sw 1255/20"

D & A