



Sec. 16 Twp. 22 R. 14W

Well No. #1 Dralle Farm

Imperial Oil Company

K & E Drlg. - Contr. Contractor

Wildcat


330' Ft. from N. Line

\_\_\_\_\_ Ft. from S. Line

330' Ft. from E. Line

\_\_\_\_\_ Ft. from W. Line

NE NE NE

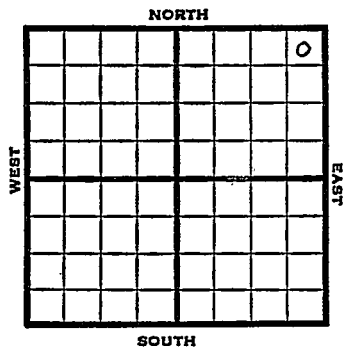

1951 Elev. 1943' REPORT

3/14 Location

4/11 Spud 3-24-51  
 D&A TD 3901  
 8" @ 306  
 Heeb. 3328 Br Lime 3454  
 Lans. 3466  
 DST 3620-39 opn  $\frac{1}{2}$  hr Rec. 10' ocm  
 Cong. 3752' Viola 3764  
 Simp 3804 Arb. 3851  
 TD 3901  
 D&A

**ABANDONED**



