


DX 78-1 Reno

Section 16 Township 22 Range 8W

Well No. #1 Zimmerman

Company Tom Allen et al

NORTH

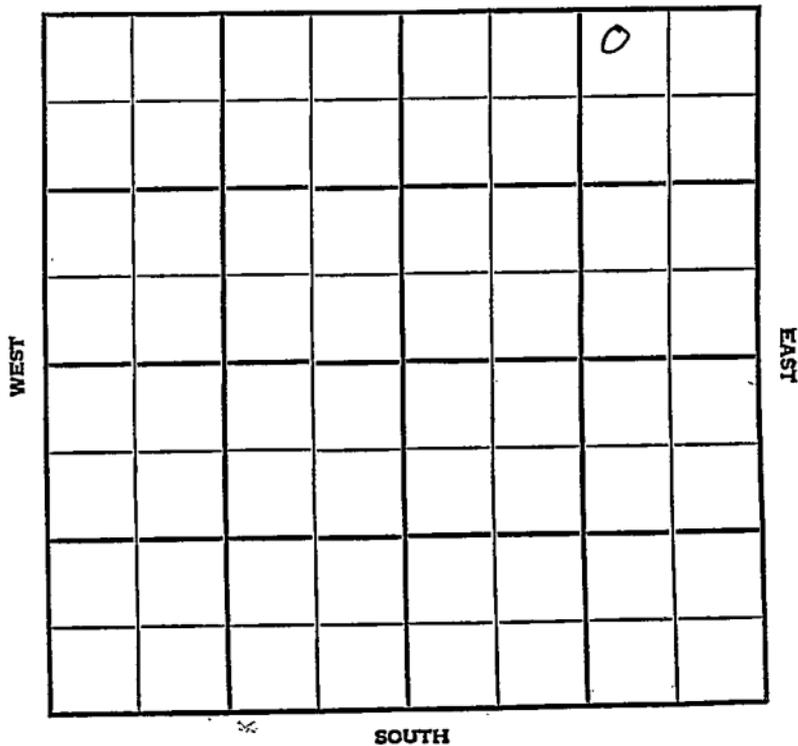

Reno

KANSAS


SEC. 16	TWP. 22	R. 8W
------------	------------	----------

WELL NO. **1 Zimmerman** FARM

COMPANY **Tom Allen et al**

CONTRACTOR **Co. Tools
Semi-Wildcat**

_____ Ft. from N. Line
 _____ Ft. from S. Line
 _____ Ft. from E. Line
 _____ Ft. from W. Line

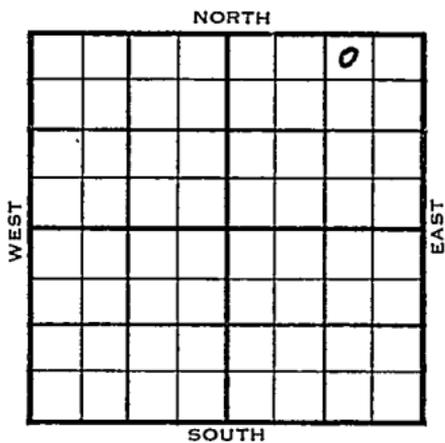

NW NE NE

	ELEVATION	REPORT
--	-----------	--------

1955

6/15

8" @ 191
D1g 2250

7/7

5 1/2" 3500/75 DD 3507, frac S/4 bo 24 bw
24 hr. DD 3582 D&A

Tops:	Depth	Datum
L.	3070	1385
M.	3499	1814
TD.	3501	

ABANDONED

County Reno Elev. _____
 Sec. 16 Twp. 22 Rge. 8W
 Company Tom Allen et al.
 Farm Name Zimmerman No. I

TOPS	DEPTH	LOG	DATUM
Anh.			
Tp.			
H.			
Tr.			
Dg.			
Bl.			
L.			
K.C.			
B.K.C.			
Ce.			
C.			
M.			
M.			
K.			
Mz.			
Me.			
V.			
S.			
S.			
A.			
R.			
Pe.			
G.			
T.P.			

Loc. in Sec. _____
NW NE NE
 Geol. _____
 Contr. _____
Co. tools
 Pool _____
Semi Wildcat

		0
FIRST REPORT		
JUN 15 55		

Date Comm. 8" @ 191 drlg. 2250

KU12

Co.
Lse.
No.
Sec.
T.
R.

