

Section 16 Township 22 Range 11WWell No. #1 SheppardCompany Eldorado Ref.

NORTH

			O				

WEST

EAST

SOUTH

Stafford
-- 22

KANSAS
T1W

Sec. 16 Twp. R.

Well No. #1 Sheppard Farm

Eldorado Ref. Company

Sterling Drlg. -Contr. Contractor

Wildcat

Ft. from N. Line

330'


Ft. from S. Line

330'

Ft. from E. Line

Ft. from W. Line

SE SE NW

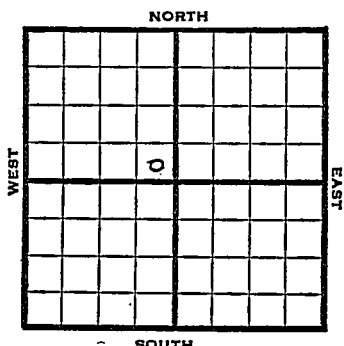

1950

Elev 1800'

REPORT

12/6

Spud 12-3-50
8" @ 296'

1951
1/24

8" @ 296

Anhy 510-25

Jeeb 3043

Br lime 3178

Lans 3201

Cong 3478

Simp 3531

Arb 3547

C

TD 3555

5" @ 3548

DST 3547-56 opn $\frac{1}{2}$ hr rec 120' ho & gcm

DD 3558

FU 250' oil 500 A S/1 boph

DD 3561 S/3 boph 2500 A

DD 3583 S/3 boph

Comp 58 bopd

Completed TD 3583'

COMPLETED

County Stafford State KansasSec. 16 (Blk. Twp.) 22 (Sur. Rge.) 11W Map No.Operator Eldorado Ref.Well No. 1 Farm SheppardElev. Location SE SE NW

		0			

FIRST REPORT

330 Ft. From S Line NW330 Ft. From E Line Quarter1st. Report DEC 6 1950


Completion

Remarks

Sterling Drlg. - Contr.Spudding Date 12-3-50Drlg. Data Wildcat8" @ 296

J. E. TYRA

County Stafford State Kansas
 Sec. 16 (Blk. 22) (Sur. 11W) (Twp. 22) (Rge. 11W) Map No.
 Operator Eldorado Ref.
 Well No. 1 Farm Sheppard
 Elev. 1800 Location SE SE NW

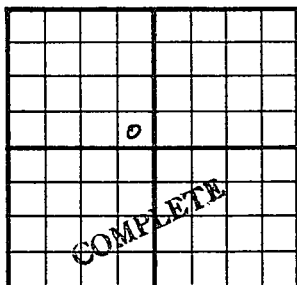

330 Ft. From S Line NW
330 Ft. From E Line Quarter
 Ist. Report
 Completion JAN 24 1951
 Remarks Wildcat
Sterling Drlg. - Contr.
 Spudding Date 12-3-50

Drlg. Data Oil well TD 3583
8" @ 296 Anhy 510-25 Heeb. 3043
Br. lime 3178 Lans. 3201 Cong. 3478
Simp. 3531 Arb. 3547 TD 3555
5" @ 3548 DST 3547-56 open $\frac{1}{2}$ hr.
Rec. 120' ho & gcm DD 3558 FU 250' oil
500 A S/ 1 boph DD 3561 S/ 3 boph
2500 A DD 3583 S/ 3 boph
Comp. 58 bopd

J. E. TYRA