


Section 16 Township 22 Range 11W

Well No. 2 Sheppard

Company Adair et al

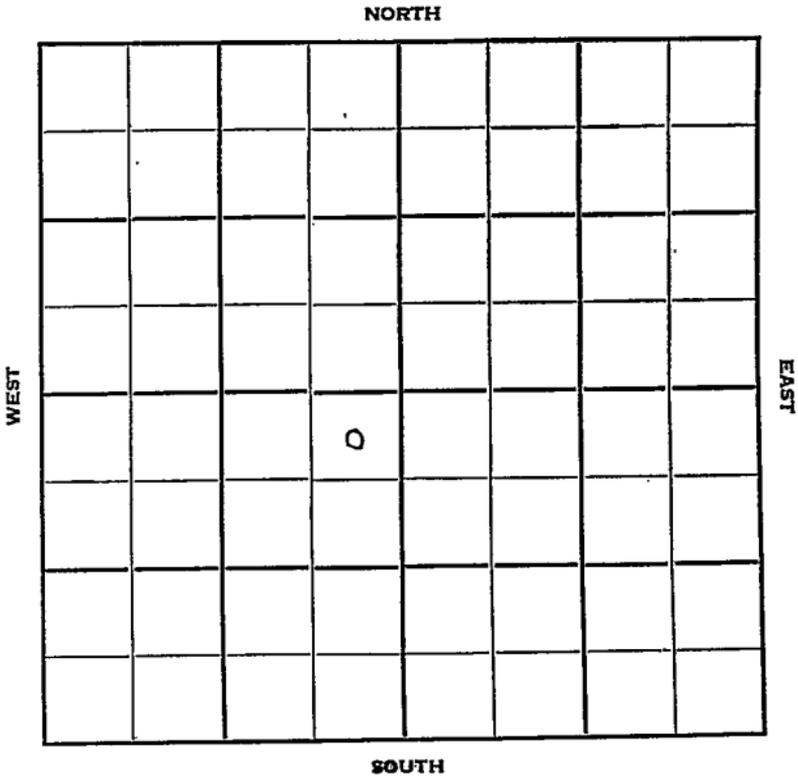

Sec. 16 Twp. 22 R. 11W

Well No. #2 Sheppard Farm

Adair et al Company

Sheppard Pool Contractor


330' Ft. from N. Line

_____ Ft. from S. Line

330' Ft. from E. Line

_____ Ft. from W. Line

NE NE SW

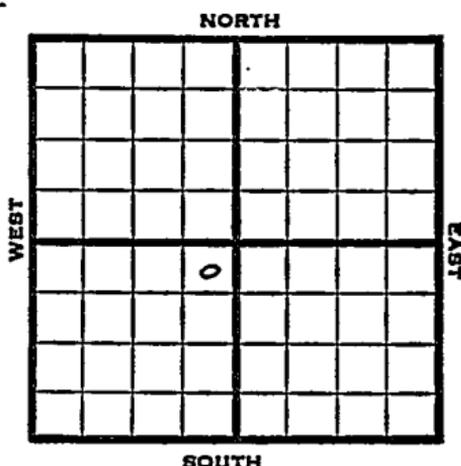

1951 Elev. 1800' REPORT

7/25 Location
10/24 7-25-51
Oil Well TD 3554
8" @ 280
Anhy 507 Heeb. 3033
Br. lm. 3165 KC 3195
Marm. 3455 Cong 3469
Viola 3473 Simp. 3504
Arb. 3529
DST 3532-49 open 10 min.
Rec. 120' HO&GCM 120' gassey oil
5" @ 3544 DD 3550 FU 300' oil
10 min. DD 3554 S & F/ 7 BOPH
500 A F/ 14 BOPH
Comp. 293 BOPD

COMPLETED

