


Section 16 Township 22 Range 12W

Well No. 1 - Spangenberg "B"

Company Heathman & Co.



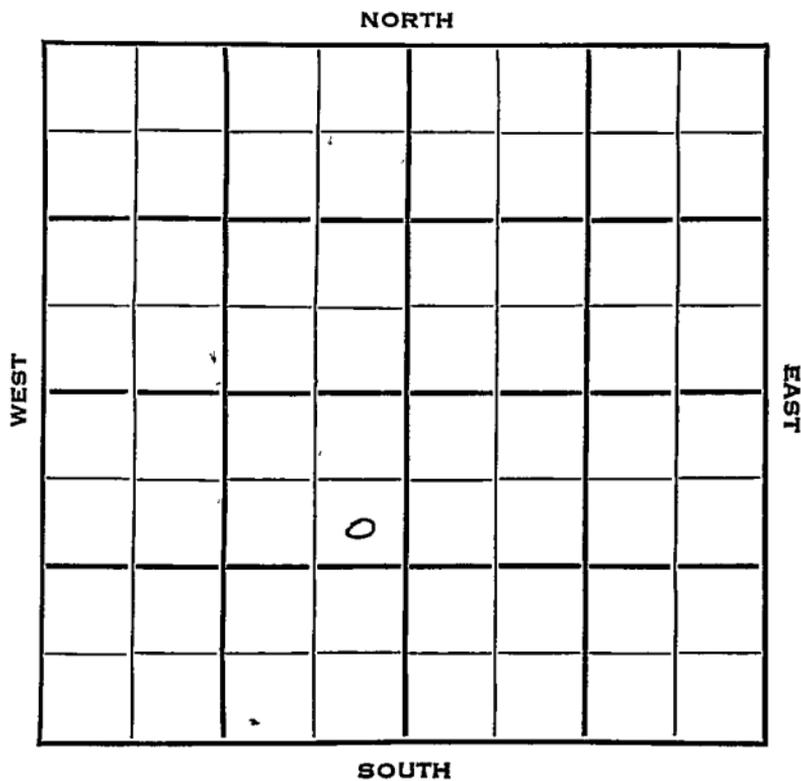

16

22

Sec. _____ Twp. _____ R. _____

#1 Spangenberg "B"

Well No. _____ Farm _____

Heathman & Co.

Company

Walters Drlg.

Contractor


990 Ft. from N. Line

_____ Ft. from S. Line

330 Ft. from E. Line

_____ Ft. from W. Line

SE NE SW

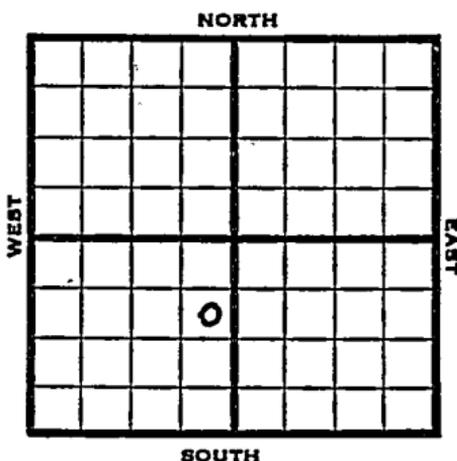

1953 Elev. 1866' REPORT

1/14 Spud 1-7-53
8" @260
Anhy 644
Drlg. 2615'

1/22 Heeb 3157, Tor 3175, Dougl
3189, Br li 3288, Lans 3307
DST 3392-3401, 1 hr., 40' M
& W 812#
DST 3458-3508, 1 hr. 25' M
V 3568
DST 3585-3624, 55 mins. 55' M
Arb. 3690
DST 3691-96, 1 hr., 1100' oil
1190#
Drlg. 3700'

1/29 RTD 3740' 5" @ 3739 CO 3710
32/3688-96 S/1 1/2 BOPH 8 hrs. POP

2/5 NR
2/12 P/36 BO + 8 BWPD
2/19 NR
2/26 N. R.
3/12 "
3/19 NR
3/26 NR
4/2 "
4/9 NR
4/16 "

OVER

#1 Spangenberg "B"

1953
4/22

Spud 1-7-53

Oil Well

TD 3740

8" @ 260

Anhy 644, Heeb 3157, Tor 3175, Doug
3189, Br lime 3288, Lans 3307

DST 3392-3401, opn 1 hr., rec. 40'
mud & wtr., 812#

DST 3458-3508, opn 1 hr., rec. 25'
mud, Viola 3568

DST 3585-3624, opn 55 mins., rec.
55' mud 0#, Arb 3690

DST 3691-96, opn 1 hr., rec. 1100'
oil, 1190#

TD 3740

5" @ 3739, CO to 3710

32/3688-96, S/1½ boph 8 hrs.

P/36 bo 8 bwpd

Comp. 54 bopd

COMPLETED

County Stafford State Kansas

Sec. 16 (Blk. Twp.) 22 (Sur. Rge.) 12W Map No.

Operator Heathman & Co.

Well No. 1 Farm Spangenberg "B"

Elev. Location SE NE SW

990 Ft. From N Line SW

330 Ft. From E Line Quarter

1st. Report JAN 14 1953

Completion

Remarks

Walters Drlg. - Contr.

Spudding Date 1-7-53

Drlg. Data

8" @ 260 Anhy 644 drlg. 2615

