


SECTION 16 TOWNSHIP 22S RANGE 12W

WELL NO. #1 Spangenberg "C"

COMPANY Petroleum Inc.

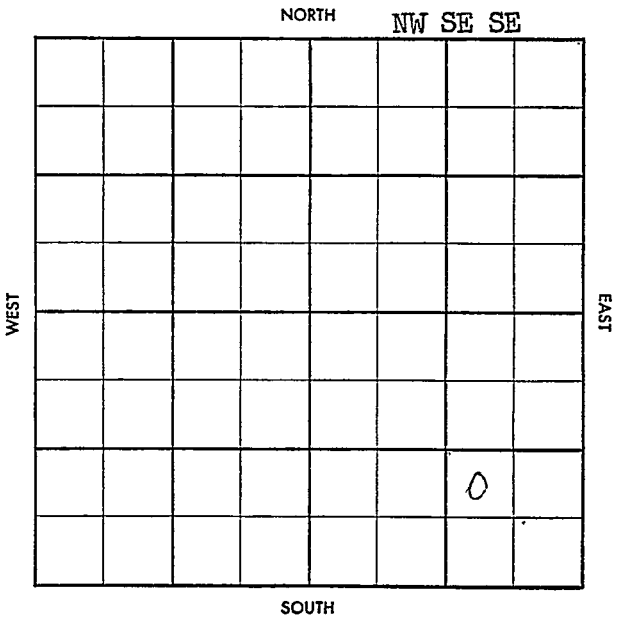

Twp. X Pool X
 Co. X Foot X

S-513-B

County Stafford Elev 1863 of 1866 RL
 Sec. 16 Twp. (22) Rge. 12W
 Company Petroleum Inc.
 Farm Name Spangenberg "G" No. 1

TOPS	DEPTH	LOG	DATUM
Anh.	640		
Tp.			
H.	3153		
Tr.	3169		
Dg.			
B.L.	3284		
L.	3310		
K.C.			
B.K.C.	3533		
Ce.			
C.			
M.			
M.			
K.			
Mz.			
Mq.			
V.	3572		
S.			
S.	3616		
A. <u>SSd</u>	<u>3622</u>		
R. <u>A</u>	<u>3686</u>		
Pf.			
G.			
F.D.	3691		

Loc. in Sec. W ST SE
 Geol. _____
 Contr. Garvey 9^H
 Pool Helene

ABANDONED
 JUL 2 '58

Date Comm. 6-17-58 8" 270/225
 Location JUN 25 '58 DST 3312 - 87 1hr
40' gem BHP 140/20 DST 3431-64
1hr 30' s gem / spk oil BHP
120/20" JUL 2 '58 DST 3471-3548
1hr 35' M VSSO FBHP 140/20
DST 3686-91 1hr 360' SW
BHP 1100/20"

D6A