


FORM 51 25M 3-49 PETROL

Section 16 Township 22 Range 12-W

Well No. #2 Schade

Company B & B Drlg
Max Pool

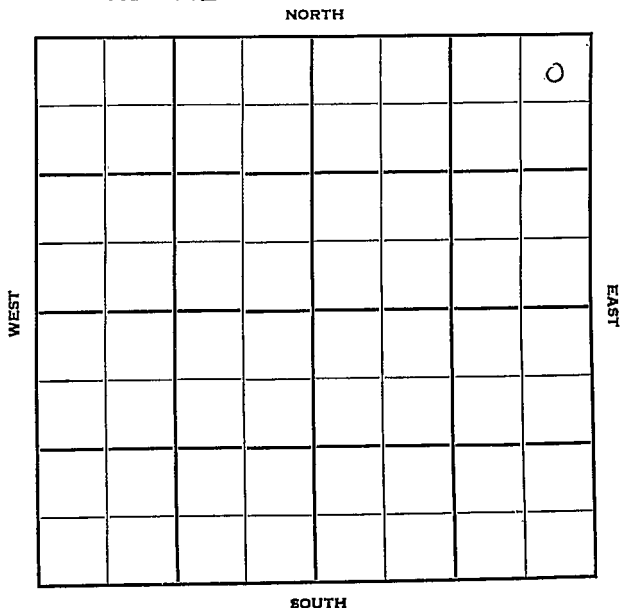

Stafford
22

KANSAS

12W

Sec. _____ Twp. _____ R. _____

#2 Schade.

Well No. _____ Farm _____

D & B Drllg.

Company _____

Contractor _____

Max. Pool


330 Ft. from N. Line

Ft. from S. Line

330' Ft. from E. Line

Ft. from W. Line

NE NE NE

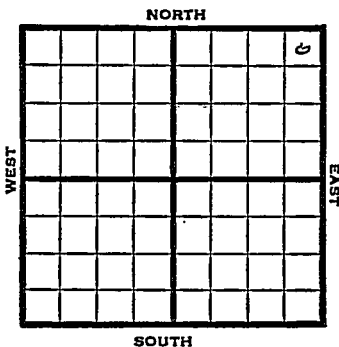

1950

Elev. 1867' REPORT

3/8

RUR

4/12

TD 3685'

8 5/8" @ 222'

Heeb 3160'

Lans 3311'

Cong 3552'

Viola 3566'

Simp 3620'

Arb. 3683'

D&A

Aband.

ABANDONED

Kansas

Map No. _____ Sec. 16 Twp. 22 R. 12WWell No. 2 Schade

_____ B & B Drlg. _____ Company

_____ Contractor

NE NE NE

E1. 1867
SECTION PLAT330

Ft. from N. Line

_____ Ft. from S. Line

330

Ft. from E. Line

_____ Ft. from W. Line

Stafford County



Location _____

Rig up _____

Drilling and Remarks:

R U R

RECORD

Cased _____ in., _____ ft.

Sand _____

Gas _____

Oil _____

Total Depth _____

PRODUCTION

1st 24 hrs. Nat. _____

1st 24 hrs. after shot _____

Gas _____ Cu. Ft.

Dry Hole _____

Abandoned _____

Date

MAR 8 1950

19

J. E. TYRA Scout

Kansas

Map No. _____ Sec. 16 Twp. 22 R. 12WWell No. 2 Schade

B & B Drllg. _____ Company

Contractor

NE NE NE

E. 1867


SECTION PLAT

330 Ft. from N. Line

_____ Ft. from S. Line

330 Ft. from E. Line

_____ Ft. from W. Line

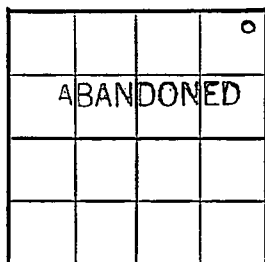

Stafford County

Location _____

Rig up _____

Drilling and Remarks:

8 5/8" @ 222
Hub 3160
Rans 3311
Cong 3552
Villa 3566
Simp 3620
arb 3683

Date

DVA

RECORD

Cased _____ in., _____ ft.

Sand _____

Gas _____

Oil _____

Total Depth 3685

PRODUCTION

1st 24 hrs. Nat. _____

1st 24 hrs. after shot _____

Gas _____ Cu. Ft.

Dry Hole _____

Abandoned _____

APR 12 1950

19

J. E. TYRA

Scout