


Section 16 Township 22 Range 12 W

Well No. # 1 Spangenburg

Company Heathman & Co.

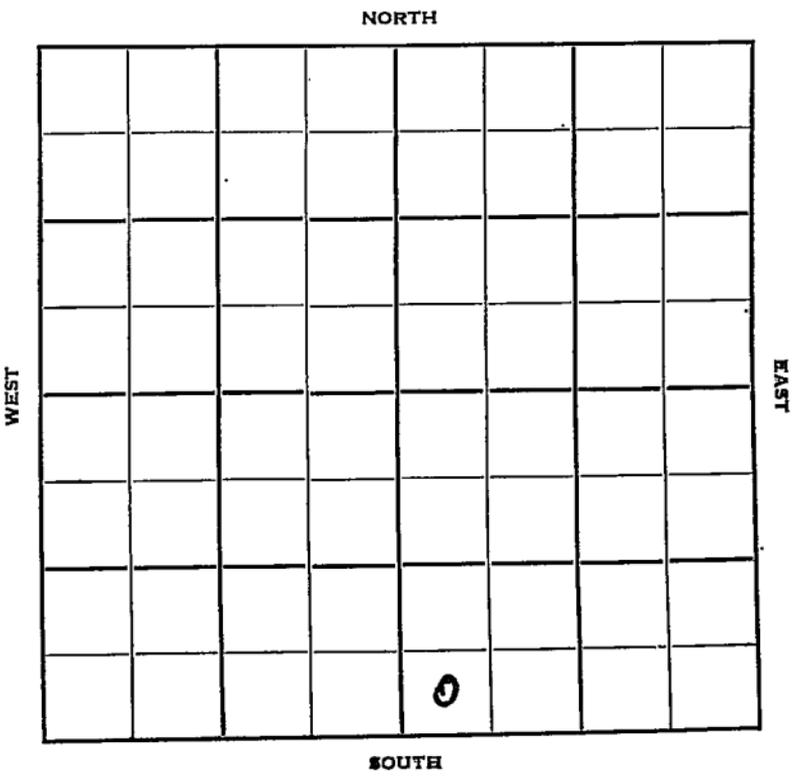

Stafford

KANSAS

Sec. 16 Twp. 22 R. 12W

Well No. #1 Spangenburg Farm

Heathman & Co. Company

Walters Drlg. Contractor
Semi-Wildcat


Ft. from N. Line

330 Ft. from S. Line

Ft. from E. Line

330 Ft. from W. Line

SW SW SE
Hilton - \$2000
Skelly, Stan. acreage

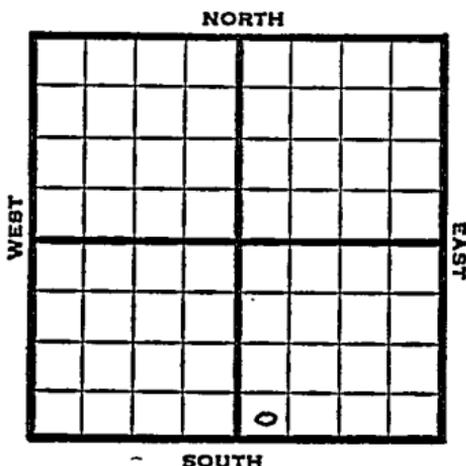

1952 Elev. 1866' REPORT

- 10/1 Spud 9-24-52
12" @ 231 Anhy 640
Drlg. 2280
- 10/8 Tor. 3172 Doug 3178
Br Li 3284 Lans. 3306
DST 3327-70 open 1 hr. rec. 900'
gas, 35' mud
DST 3430-68 open 1 hr. rec. 25' mud
DST 3470-3506 open 1 hr. rec. 30' mud
Viola 3565 Simp. 3611
Arb. 3687
DST 3685-95 open 1 hr. rec. 630'
oil, nowtr. TD 3695' 5" @ 3689
- 10/15 CO to 3695 S/9 BOPH POP
- 10/22 Spud 9-24-52
Oil well TD 3695' 12" @ 231
Anhy 640' Tor. 3172' Doug. 3178'
Br. lime 3284' Lans. 3306'
DST 3327-70 open 1 hr. rec 900' gas
35' mud
DST 3430-68 open 1 hr. rec 25' mud
DST 3470-3506 open 1 hr. rec 30' mud
Viola 3565' Simp. 3611' Arb. 3687'
DST 3685-95 open 1 hr. rec 630' oil
TD 3695' 5" @ 3689 CO to 3695'
FU 1500' oil 3 hr. S/9 BOPH
Comp. 223 BOPD

COMPLETED

