

KANSAS

Section 16 Township 22 Range 12W

Well No. 1 - Spangenberg

Company Skelly Oil

NORTH

WEST

EAST

SOUTH

Stafford

KANSAS ✓

Sec. 16 Twp. 22 R. 12WWell No. 1 Spangenberg FarmSkelly Oil Company


Contractor

Ft. from N. Line

330 Ft. from S. Line330 Ft. from E. Line

Ft. from W. Line

SE SE SW

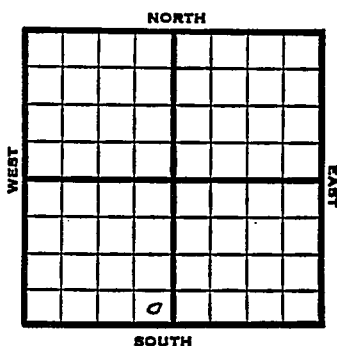

1952

Elev. 1867' REPORT

12/30 Spudding 12/26/52
Anhy 660 8" @ 670 WOC1/1 WOC
1/8 Ø 3215

1953

1/14

Spud 12-26-52

D&A TD 3710

Anhy 660

8" @ 670

Heeb 3164, Tor 3181, Doug
3199, Br lime 3295, Lans 3315DST 3438-76, opn 1 hr., rec.
30' mud 62#Viola 3584, Simp 3629, Arb.
3703

DST 3704-10, opn 1 hr., rec.

35' blk hyv oil 315' wtr., 150'
clean wtr. 1345#

D&A

ABANDONED

County Stafford State KansasSec. 16 (Blk.) 22 (Sur.) 12W Map No.Operator Skelly OilWell No. 1 Farm SpangenbergElev. _____ Location SE SE SW

FIRST REPORT

330 Ft. From S Line SW330 Ft. From E Line Quarter1st. Report DEC 30 1952

Completion _____


Remarks _____

Spudding Date 12-26-52

Drig. Data _____

Anhy 660 8" @ 670 WOC

County Stafford State Kansas
 Sec. 16 (Blk. 22 (Sur. 12W Map No.
 (Twp.) (Rge.)
 Operator Skelly Oil
 Well No. 1 Farm Spangenberg
 Elev. 1867 Location SE SE SW

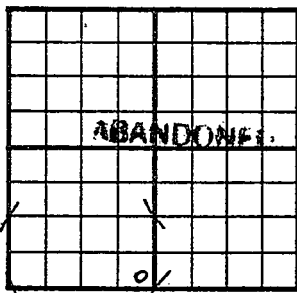

330 Ft. From S Line SW
330 Ft. From E Line Quarter

1st. Report

Completion JAN 14 1953

Remarks

Spudding Date 12-26-52

Drlg. Data D & A TD 3710

Arhy 660 8" @ 670 Heeb. 3164

Tor. 3181 Doug. 3199 Br. lime 3295

Lans. 3315 DST 3438-76 open 1 hr.

Rec. 30' mud 62# Viola 3584

Simp. 3629 Arb. 3703 DST 3704-10

open 1 hr. Rec. 35' blk. hvy oil 315' wtr.

150' clean wtr. 1345#

D & A

J. G. McGEHEE