


Section 16 Township 22 Range 1W

Well No. 1 Dunkleberger

Company Mid-Plains et al

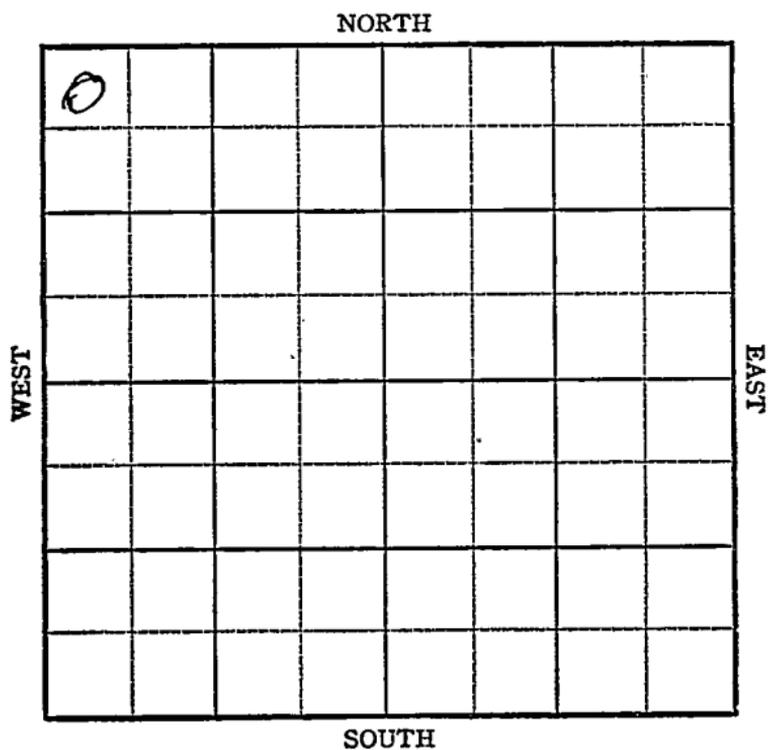

Sec. 16 Twp. 22 R. 1-W ✓

Well No. #1 Dunkleburger Farm
Mid-Plains etal. Company
Wildcat


330 Ft. from N. Line

 Ft. from S. Line

 Ft. from E. Line

330 Ft. from W. Line

NW/C

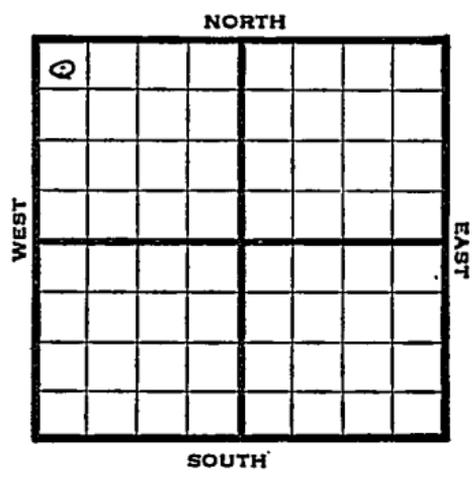

1948 REPORT	
8/4	Eli 1478' Location
8/11	8" @ 240'
8/18	^U rlg 2525'
8/25	Mississippi 2978'
9/1	Drlg 3184'
	Hunton 3318'
	Vuola 3468'
	Simp Sand 3514'
	TD 3543'
	Aband.
	ABANDONED

Harvey County Kansas State

Map No. Sec. 16 Twp. 22 R. 1W

Well No. 1 Dunkleberger

Mid-Plains etal. Company

FIRST REPORT

NW/C Contractor

SECTION PLAT

330 Ft. from N. Line

Ft. from S. Line

Ft. from E. Line

330 Ft. from W. Line

0							

Wildcat

Remarks:

Location

31-1-1
 087A 001 0-9
 11300-11-10

Date AUG 4 1948

Scout S. J. LEWIS

Harvey County Kansas State

Map No. 43 Sec. 16 Twp. 22 R. 1W

Well No. 1 Dunkleberger

Mid-Plains etal. Company

ABANDONED

Contractor

NW/C

E11478-

SECTION PLAT

330 Ft. from N. Line

_____ Ft. from S. Line

_____ Ft. from E. Line

330 Ft. from W. Line

o					

Wildcat

Remarks:

Hunter 3315
Violet 3465
Bing sand 3514
FD 3573

Date
 SEP 1 1948

Scout **S. J. LEWIS**