


Map No. **KANSAS** Sec. 16 Twp. 22 R. 2W

Well No. 1 Ruth Farm O. J. Connell et al Company

Harvey

NORTH

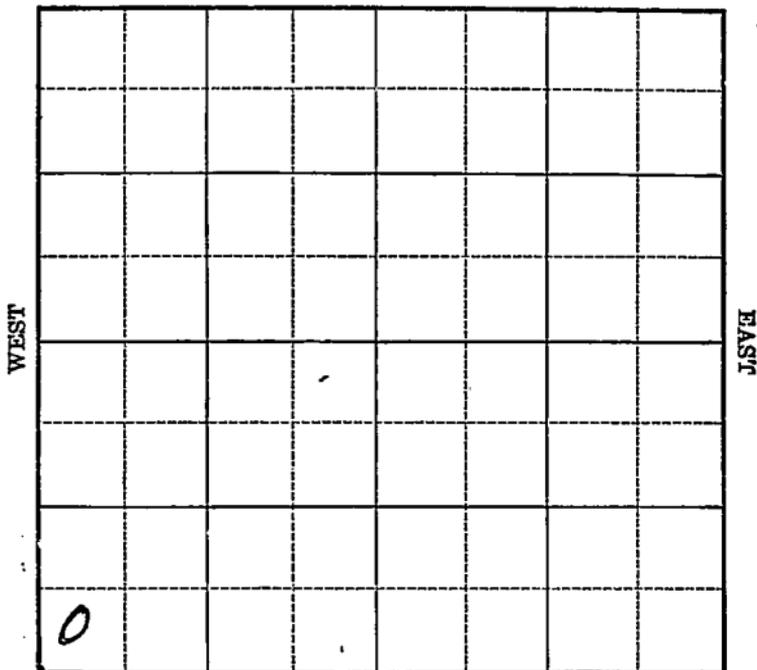

SOUTH

Location _____

Drilling Remarks _____

Rig Up _____

Drilling Remarks _____

RECORD

Cased _____ in. _____ ft.

Sand _____

Gas _____

Oil _____

Total Depth _____

PRODUCTION

1st 24 hrs. Nat. _____

1st 24 hrs. after shot _____

Gas _____ cu. ft.

Dry Hole _____

Abandoned _____

Harvey

Map No. KANSAS Sec. 16 Twp. 22 R. 2 W


Well No. 1 Ruth Farm _____
O. J. Connell et al Company _____

_____ Ft. from N. Line

330 Ft. from S. Line

_____ Ft. from E. Line

330 Ft. from W. Line

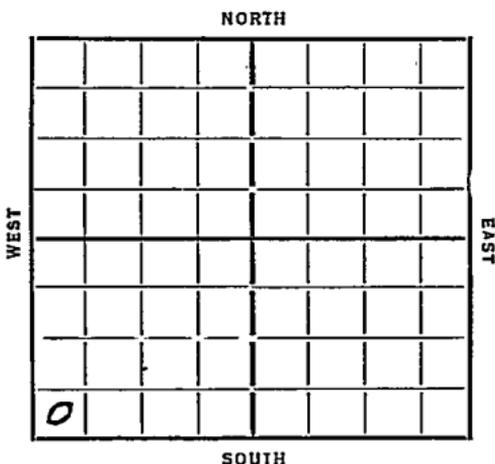

Date	REPORT
1934	
10/31	Location
11/8	_____
11/15	Spud
11/27	_____ 11/28 _____ 12/6 _____ 12/13 _____
12/21	_____ 12/27 _____ 1/3/35 _____ 1/10 _____
1/17	Rig
1/24	_____ 1/31 _____ 2/7 _____ 2/14 _____
2/21	_____ 2/28 _____ 3/7 _____ 3/14 _____
3/21	_____
3/28	Spud
4/4	8" 925 13 3/8 13 7
4/11	10" 1585
4/18	8" 7170 8" 2062
4/26	HFW 2370-85
	U R 8" 2400
5/2	8" 2455 HFW 2600
	2612 log
5/9	8" 2750 8" 2610
5/16	" 3020 2825-35 HFW.
5/23	" 3250 Chert 3205
5/29	3275 U R 6"

(OVER)

6/6 6" 3288 HFW 3330
T 7 3345 WR 7"

6/13 7" 3339 147W 3365-75
Relg 3475

6/20 Relg 3650

6/28 " 3758

7/3 —

7/10 Viola 3747
T 7 3758

7. A.

ABANDONED

Map No. 43 Sec. 16 Twp. 22 R. 2W

Well No. 1 - Ruth

O. J. Connell et al Company

Contractor

FIRST REPORTS

SECTION PLAT

_____ Ft. from N. Line

330 Ft. from S. Line

_____ Ft. from E. Line

330 Ft. from W. Line

Location

Rig up _____

Drilling and Remarks:

RECORD

Cased _____ in., _____ ft.

Sand _____

Gas _____

Oil _____

Total Depth _____

PRODUCTION

1st 24 hrs. Nat. _____

1st 24 hrs. after shot _____

Gas _____ Cu. Ft.

Dry Hole _____

Abandoned _____

Date

10-31-34 19

ORVAL MANNSCHRECK
Scout

Map No. 45 Sec. 16 Twp. 22 R. 2W

Well No. 1-Ruth

O. J. Connell Company

Contractor

ABANDONED

SECTION PLAT

.....Ft. from N. Line

330 Ft. from S. Line

.....Ft. from E. Line

330 Ft. from W. Line

0			

RECORD

Location.....

Cased..... in., ft.

Rig up.....

Sand Water 3747

Drilling and Remarks:

Gas.....

Oil.....

Total Depth 3758

DAF

PRODUCTION

1st 24 hrs. Nat.....

1st 24 hrs. after shot.....

Gas..... Cu. Ft.

Dry Hole.....

Abandoned.....

Date

7-10-35 ORVAL MANN SCHRECK Scout