

KANSAS

Pawnee

FORM 51 5M 10-41 PETROL

Section 16 Township 22 Range 20-W

Well No. #1 Thompson

Company Adair & Morton et al

NORTH Wildcat

		0					

WEST

EAST


SOUTH

Sec 16 Twp. 22 R. 20-WWell No. #1 Thompson FarmAdair & Morton et al Company

(Wildcat)

330 Ft. from N. Line Ft. from S. Line990 Ft. from E. Line Ft. from W. Line

Elev. 2199

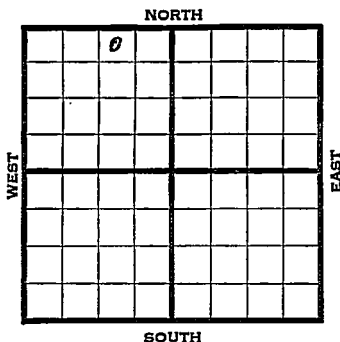

1942	REPORT
4/1	Location
4/8	"
4/15	13" - 160' WOC.
4/22	Anhy 1285' Drlg. 2800'
4/29	Herrington 2320' Ft. Riley 2435'
	Base Florence 2565' Wreford 2640'
	Cottonwood 2775' Neva 2835'
	Tarkio 3214' Topeka 3500'
	Lans. 3840' Drlg. 3955'
5/6	Cong. 4346' Miss. 4424'
	Drlg. 4597'
5/13	Viola 4601' Cherty Cong. 4545'
	Simp. 4593' Arb. 4960'
	Drlg. 5012'
5/20	Arb. 4960'
	T.D. 5012'
	No shows.
	ABANDONED

Pawnee

KANSAS

Map No. 80 Sec. 16 Twp. 22 R. 20WWell No. 1 ThompsonAdair & Merton et al. CompanyFIRST REPORT Contractor

NW NE NW

330 Ft. from N. Line Ft. from S. Line990 Ft. from E. Line Ft. from W. Line

SECTION PLAT

	o		

WILDCAT

Location XXRig up

Drilling and Remarks:

RECORD

Cased in., ft.Sand Gas Oil Total Depth

PRODUCTION

1st 24 hrs. Nat. 1st 24 hrs. after shot Gas Cu. Ft.Dry Hole Abandoned

Date

APR 1 1942 19 S. J. LEWIS Scout

Map No. 80 Sec. 16 Twp. 22 R. 20WWell No. 1 ThompsonAdair & Morton et al. Company**ABANDONED**

Contractor

NW NE NW

SECTION PLAT

	0		

330 Ft. from N. Line Ft. from S. Line990 Ft. from E. Line Ft. from W. Line**WILDCAT**Location Rig up

Drilling and Remarks:


RECORD

Cased in., ft.Sand Gas Oil Total Depth 5012

PRODUCTION

1st 24 hrs. Nat. 1st 24 hrs. after shot Gas Cu. Ft.Dry Hole Abandoned

Date

MAY 20 1942 19S. J. LEWIS Scout