


Finney

KANSAS

SECTION 16 TOWNSHIP 22 RANGE 32W

WELL NO. #1 Hett

COMPANY A.D. McKelvy

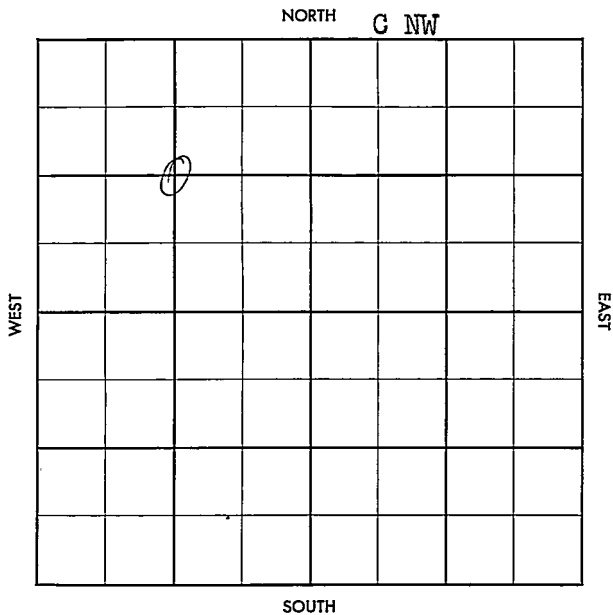

County Finney Elev. _____
 Sec. 16 Twp. 22 Rgs. 32W
 Company A. D. McKelvy
 Farm Name Hett No. 1

TOPS	DEPTH	LOG	DATUM
Anh.			
Tr.			
H.			
Tr.			
Dg.			
BL.			
L.			
K.C.			
B.K.C.			
Ce.			
C.			
M.			
M.			
K.			
Mz.			
Mo.			
V.			
S.			
S.			
A.			
R.			
PE.			
G.			
TD.			

Loc. in Sec.

C NW

Geol.

Contr. Graham-

Machaelis Tls

Pool

Hugoton

FEB 27 '57

FIRST REPORT

Date Comm. 2-25-57Temp. TD 403, 8" @ 402/250 WOC

Co.

Twp.

No.

Sec.

T.

R.

County Finney Elev. 2893
 Sec. 16 Twp. 22 Rge. 32W
 Company A. D. McKelvy
 Farm Name Hett No. 1

TOPS	DEPTH	LOG	DATUM	Loc in Sec.
Anb. <u>HETT</u>		<u>2595</u>		<u>C NW</u>
Top. <u>WKR</u>		<u>2629</u>		
H. <u>WKR</u>		<u>2646</u>		
Tr. <u>WFD</u>		<u>2687</u>		
Dg.				
Bl.				
L.				
K.C.				Geol.
B.K.C.				Contr. <u>Graham-</u>
Ce.				<u>Machaelis Tl</u>
C.				
M.				Pool
M.				<u>Hugoton</u>
K.				
Mz.				
Mo.				
V.				
S.				
S.				
A.				
R.				
PE.				
G.				
TD.	<u>2690</u>			

Geol. _____
 Contr. Graham-
Machaelis Tl
 Pool
Hugoton

MAR 20 '57
 6
 COMPLETE

Date Comm. 2-25-57Temp. TD 403, 8" @ 402/250 WOC MAR 6 '575 1/2 2688/300 " 13 '57MICT CO 2694 & WTRPKR @ 2668 50d O.H. 60/2652-62 48/2640-48 Frac4 x 2 ga 4.77 MCFG 72-20ga 10.100 MCFG RP 418#