

Finney


KANSAS

SECTION 16 TOWNSHIP 22 RANGE 34 W

WELL NO. #1 Peterson

COMPANY Southwestern Explor.

NORTH

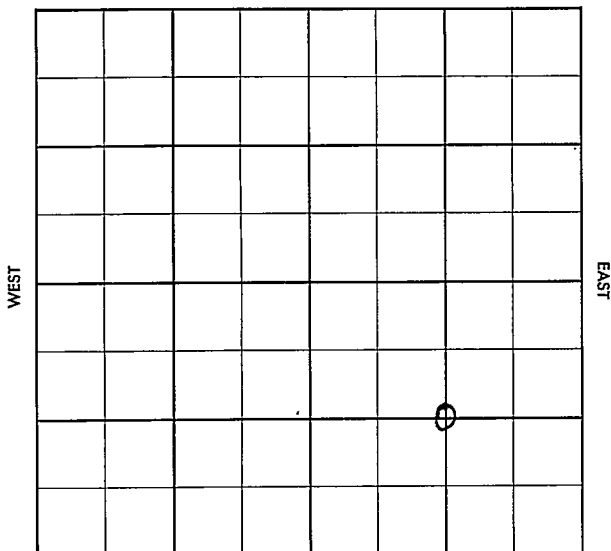

SOUTH

Finney

KANSAS

SEC.

16

TWP.

22

R.

34W

WELL NO.

#1 Peterson

FARM

COMPANY

Southwestern Explor.

CONTRACTOR

Co. Tools


Hugoton

_____ Ft. from N. Line

_____ Ft. from S. Line

_____ Ft. from E. Line

_____ Ft. from W. Line

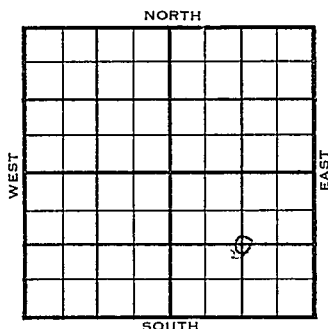

C SE/4

1955

ELEVATION

2949'

REPORT

10/19

M I R

12-14

Comm. 11-14-55

8 5/8" @ 255/200

5 1/2" @ 2648/400

CO to 2640 20/ 2625-30 1000 A

1,550 mcfg frac, 2 mcgg, SI 48 hrs.

Comp. 4,650 mcfgpd, 350#

Holt. 2528

Herr. 2560

Kri 2578

Winf 2612

TD 2650

COMPLETED

County

~~Finney~~

Elev.

Sec.

16

Twp.

22

Rge.

3NW

Company

Southwestern Explor.

Farm Name

Peterson

No.

1

TOPS

DEPTH

LOG

DATUM

Loc. in Sec.

Anh.

Tp.

H.

Tr.

Dg.

Bl.

L.

K.C.

B.K.C.

Ce.

C.

M.

M.

K.

Mz.

Mq.

V.

S.

S.

A.

R.

Pe.

G.

T.D.

Geol.

Contr.

Co. tools

Pool

Higdon

FIRST REPORT

OCT 9 1955

Date Comm.

M I R

Co.

Lse.

No.

Sec.

T.

R.

52

County Finney Elev. 2949
 Sec. 16 Twp. 22 Rge. 31W
 Company Southwestern Explor.
 Farm Name Peterson No. 1

TOPS	DEPTH	LOG	DATUM	Loc. in Sec.
Anb. <u>/</u>				C SE/4
L.				Geol.
K.C.				Contr.
B.K.C.				Co. tools
Ce.				Pool
C.				Hugoton
M.				COMPLETE
M.				
K.				
Mz.				
Mo.				
V.				
S.				
S.				
A.				
R.				
Pe.				
G.				
T.D.	<u>2650</u>			

Date Comm. 11-14-55 DEC 14 1955

8 5/8" @ 255/200 5 1/2" @ 2648/400

CO to 2640 20/ 2625-30 1000 A

1,550 mcfg frac 2 mcfg SI 48 hr.

Comp. 4,650 mcfgpd 350#