FORM 51 25M 3-49 PETROL


KANSAS

Stafford

Section 17 Township 22 Range 11-W

Well No. #1 Justus

Company Finston & Murfin

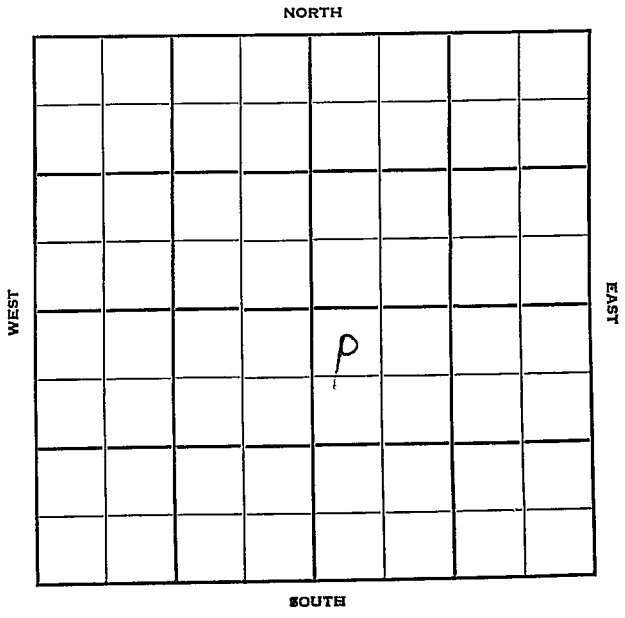

FORM 252-B
10M 9-49 PETROL

KANSAS

Stafford

Sec. 17 Twp. 22 R. 11-W

Well No. #1 Justus Farm

Finston & Murfin Company

Contractor

Wildcat

330 Ft. from N. Line


Ft. from S. Line

Ft. from E. Line

330 Ft. from W. Line

NW NW SE

CSO farmout

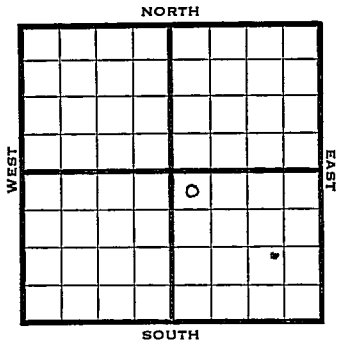

1950	Elev 1825 REPORT
7/12	MIM
8/2	8" @ 221
	Anhy 560 Heeb 3085
	Br lime 3223 lans 3251
	DST 3334-46 opn ½ hr rec 135' socm
	Comg 3551 Viola 3704
	Arb 3719-85 TD
	D&A
	ABANDONED

Form 26 200 Bks. 11-49 Petrol

Wildcat

Kansas

Map No. _____ Sec. 17 Twp. 22 R. 11W

Well No. 1 Justus

Finston & Murfin Company

_____ Contractor

NW NW SE

330 Ft. from N. Line

_____ Ft. from S. Line

_____ Ft. from E. Line

330 Ft. from W. Line

Stafford County

SECTION PLAT



CSO farmout

Location _____

Rig up _____

Drilling and Remarks:

M I M

RECORD

Cased _____ in., _____ ft.

Sand _____

Gas _____

Oil _____

Total Depth _____

PRODUCTION

1st 24 hrs. Nat. _____

1st 24 hrs. after shot _____

Gas _____ Cu. Ft.

Dry Hole _____

Abandoned _____

Date

JUL 12 1950 19

J. E. TYRA Scout

FORM 275 FOR SALE BY KANSAS BLUE PRINT CO.


County Stafford State Kansas

Sec. 17 (Blk. Twp.) 22 (Sur. Rge.) 11W Map No.

Operator Finston & Murfin

Well No. 1 Farm Justus

Elev. 1825 Location NW NW SE

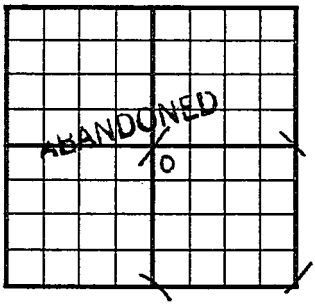

330 Ft. From N Line SE

330 Ft. From W Line Quarter

1st. Report

Completion AUG 2 1950

Remarks

Cities Service farmout

Spudding Date

Drlg. Data Wildcat

8" @ 221 Anhy 560 Heeb. 3085

Br. lime 3223 Lans. 3251 DST 3334-46

open 1/2 hr. Rec. 135' socm

Comg. 3551 Viola 3704 Arb. 3719-85 TD

D & A

J. E. TYRA